



Exhibit E

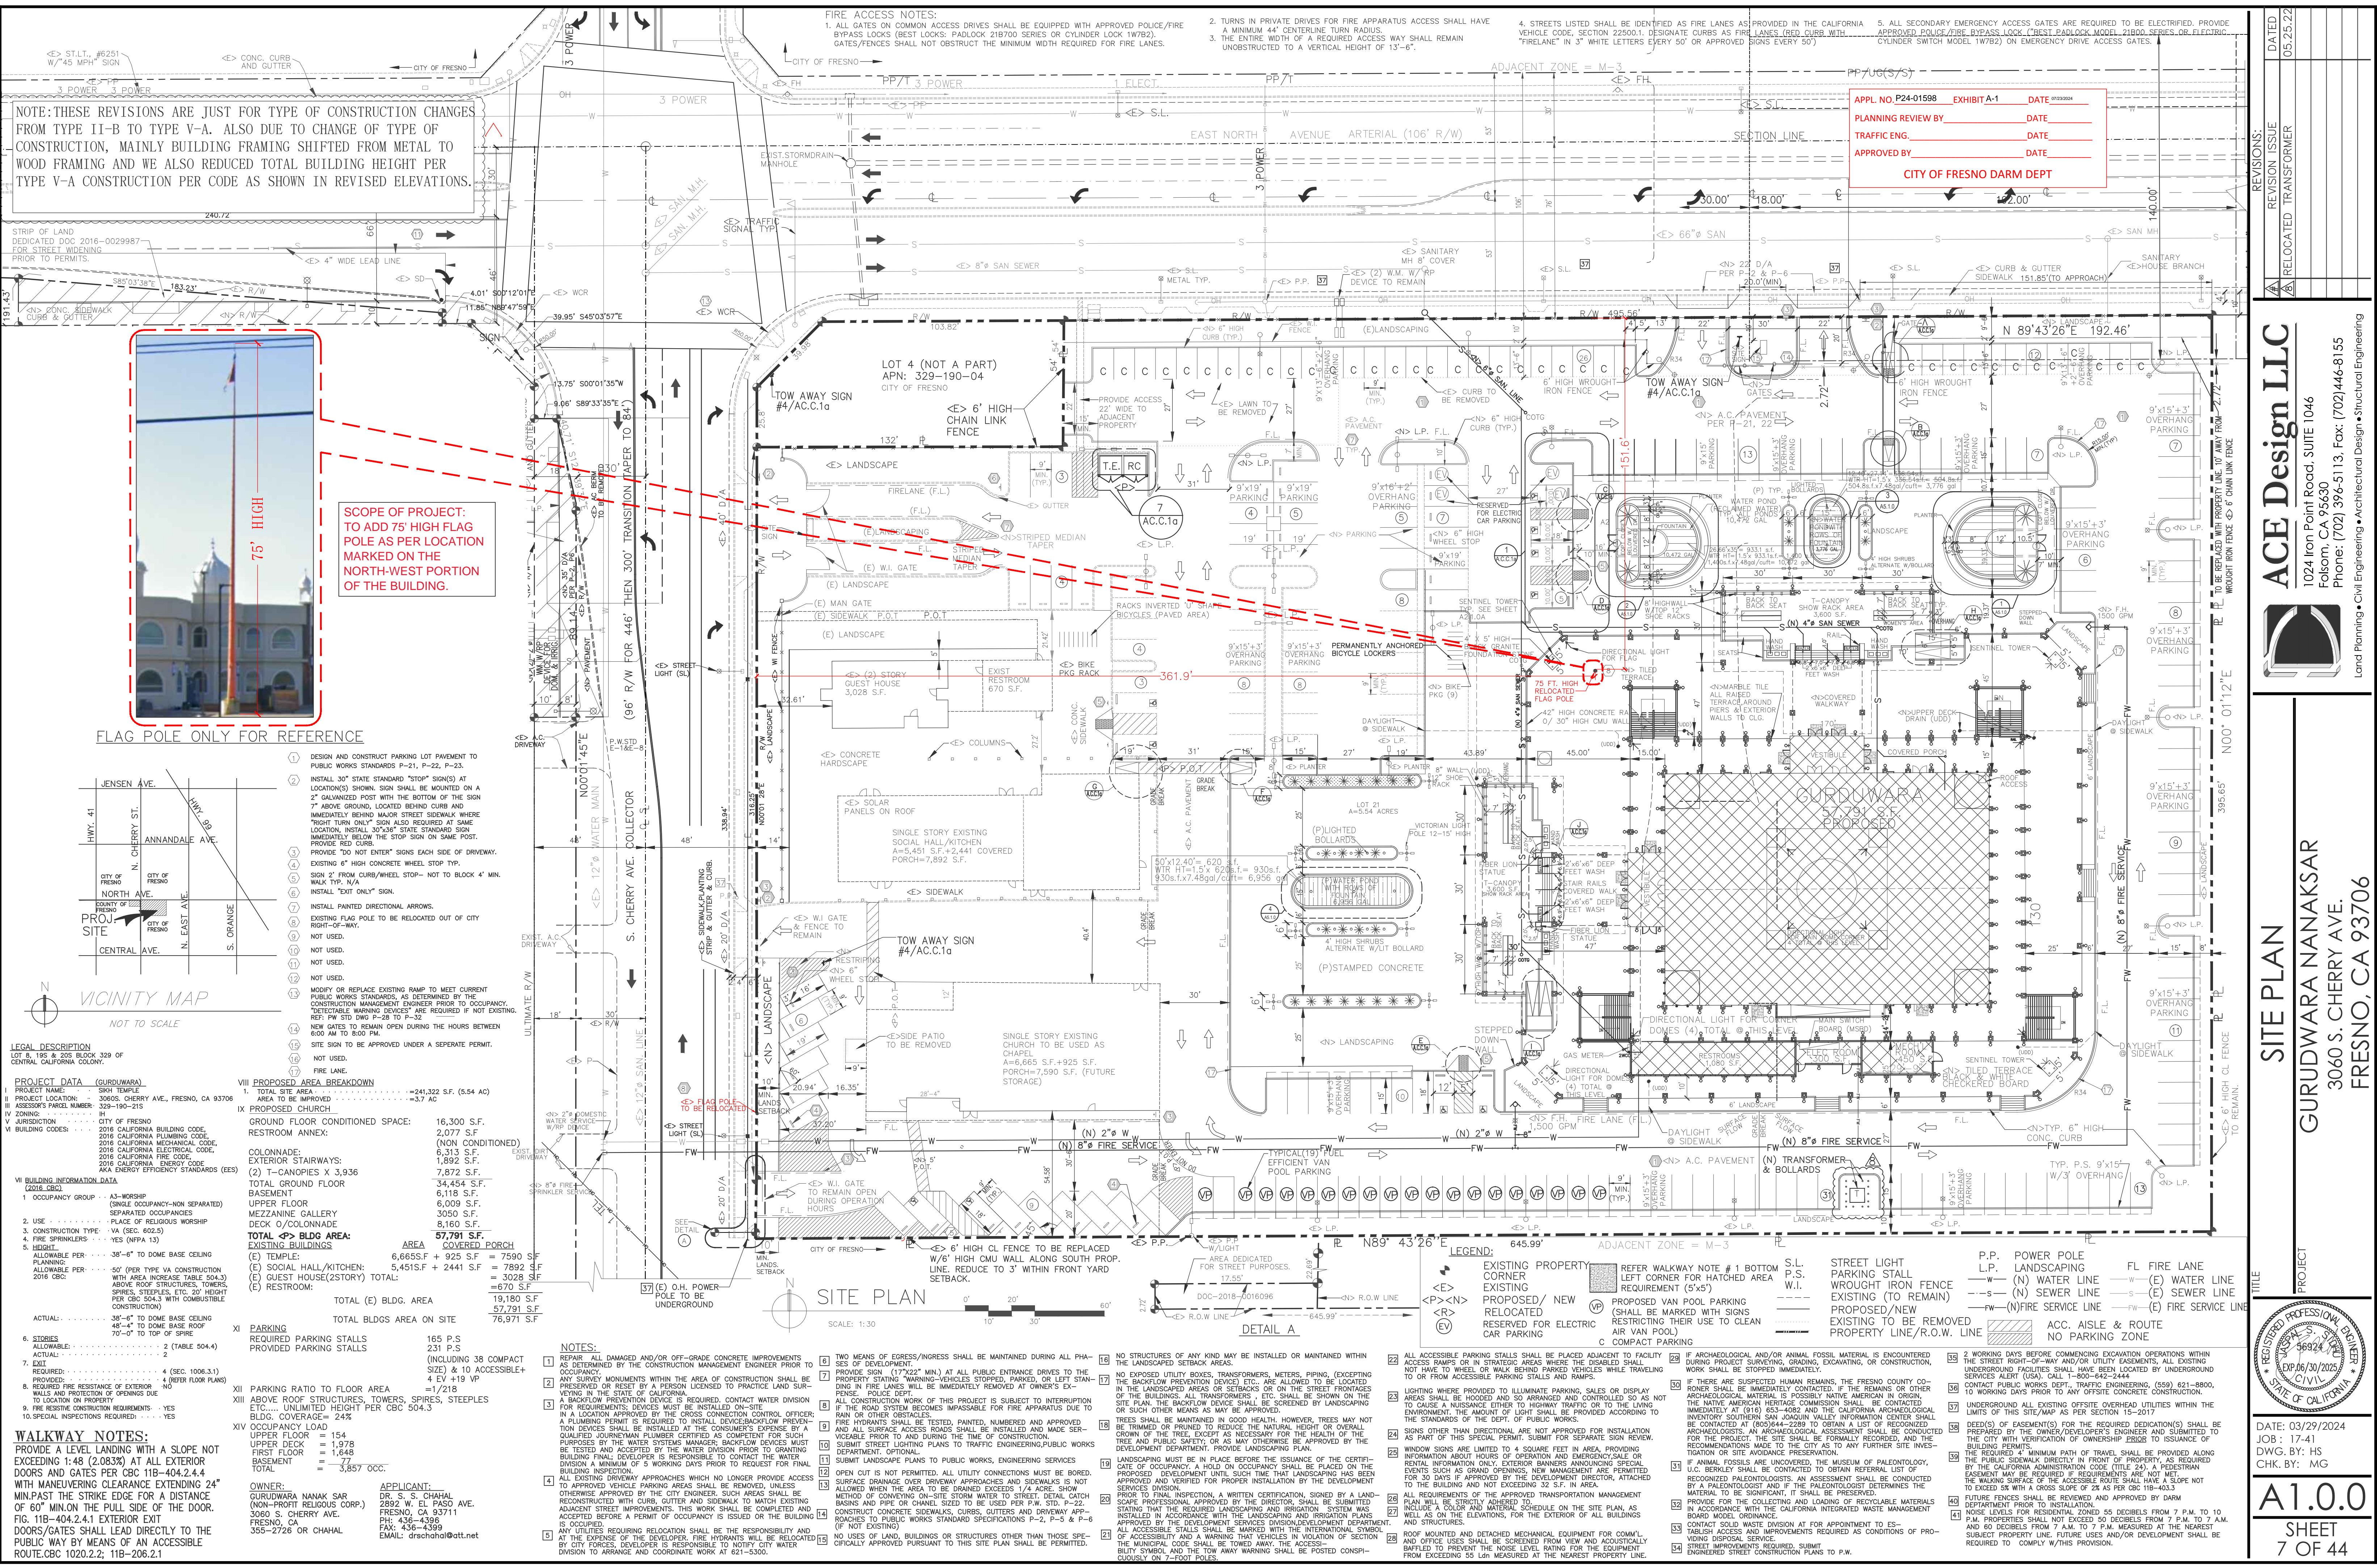


NOTE: THESE REVISIONS ARE JUST FOR TYPE OF CONSTRUCTION CHANGES FROM TYPE II-B TO TYPE V-A. ALSO DUE TO CHANGE OF TYPE OF CONSTRUCTION, MAINLY BUILDING FRAMING SHIFTED FROM METAL TO WOOD FRAMING AND WE ALSO REDUCED TOTAL BUILDING HEIGHT PER TYPE V-A CONSTRUCTION PER CODE AS SHOWN IN REVISED ELEVATIONS.

STRIP OF LAND DEDICATED DOC 2016-0029987 FOR STREET WIDENING PRIOR TO PERMITS.

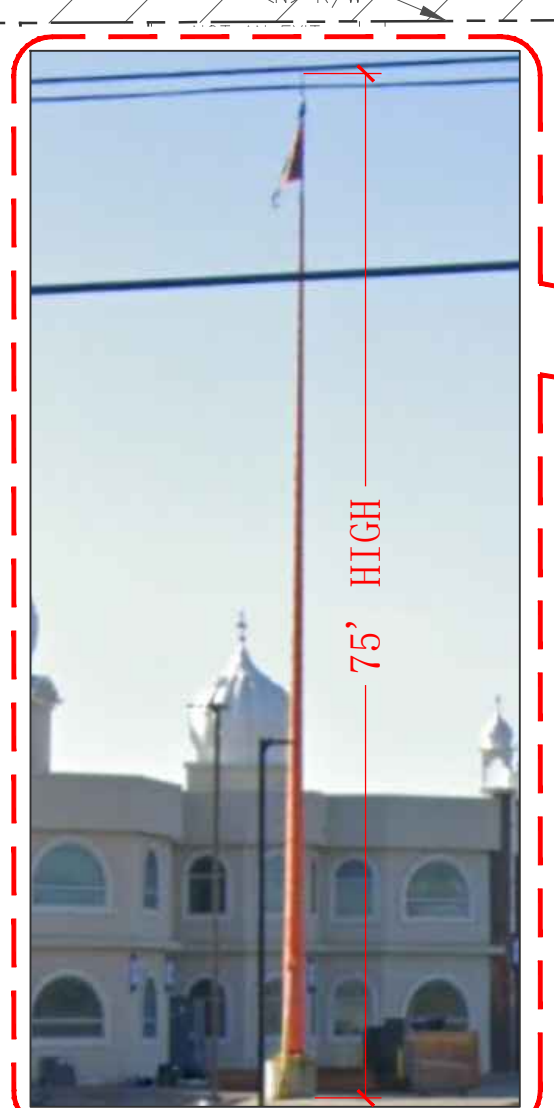

SCOPE OF PROJECT: TO ADD 75' HIGH FLAG POLE AS PER LOCATION MARKED ON THE NORTH-WEST PORTION OF THE BUILDING.

FLAG POLE ONLY FOR REFERENCE

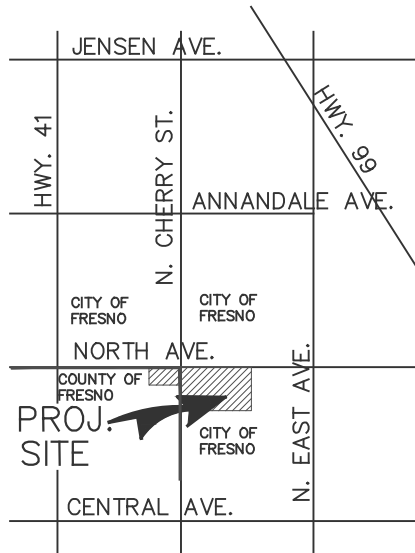

VICINITY MAP
NOT TO SCALE

LEGAL DESCRIPTION
LOT 5, 192' X 225' BLOCK 329 OF CENTRAL CALIFORNIA COLONY.

PROJECT DATA (GURUDWARA)
 I. PROJECT NAME: SRIH TEMPLE
 II. PROJECT LOCATION: 3060S. CHERRY AVE., FRESNO, CA 93708
 III. ASSessor'S PARCEL NUMBER: 329-190-015
 IV. ZONING: IH
 V. JURISDICTION: CITY OF FRESNO
 VI. BUILDING CODES: 2016 CALIFORNIA BUILDING CODE, 2016 CALIFORNIA MECHANICAL CODE, 2016 CALIFORNIA ELECTRICAL CODE, 2016 CALIFORNIA FIRE CODE, 2016 CALIFORNIA ENERGY CODE, AIA ENERGY EFFICIENCY STANDARDS (EES)

VIII. BUILDING INFORMATION DATA (CODE 5002)
 1. OCCUPANCY GROUP: A3-WORSHIP (SINGLE OCCUPANCY-NON SEPARATED) SEPARATED OCCUPANCIES
 2. USE: PLACE OF RELIGIOUS WORSHIP
 3. CONSTRUCTION TYPE: VA (SEC. 602.5)
 4. FIRE SPRINKLERS: YES (NEPA 13)
 5. HEIGHT: ALLOWABLE PER 38'-0" TO DOME BASE CEILING PLANNABLE PER 50' (PER TYPE VA CONSTRUCTION 2016 CBC). WITH AREA INCREASE TABLE 504.3 ABOVE ROOF STRUCTURES, TOWERS, SPIRES, STEEPLES, ETC. 20' HEIGHT PER CBC 504.3 WITH COMBUSTIBLE CONSTRUCTION
 ACTUAL: 38'-0" TO DOME BASE CEILING 48'-4" TO DOME BASE ROOF 70'-0" TO TOP OF SPIRE

VI. FIRE RESISTANCE REQUIREMENTS - YES
 6. STORIES: ALLOWABLE: 2 (TABLE 504.4) ACTUAL: 2 (TABLE 504.4)
 7. EXIT: PROVIDED: 4 (SEC. 1006.3.1) PROVIDED: 4 (ENTER FLOOR PLANS)
 8. RESISTANCE TO FIRE OF EXTERIOR WALLS AND PROTECTION OF OPENING: NO
 9. FIRE RESISTANCE REQUIREMENTS - YES
 10. SPECIAL INSPECTIONS REQUIRED: YES

VIII. PROPOSED AREA BREAKDOWN
 I. TOTAL SITE AREA: 241,322 S.F. (5.54 AC)
 II. PROPOSED CHURCH: 3,574 S.F.
 III. RESTROOM ANNEX: 2,077 S.F. (NON CONDITIONED)
 IV. COLONADE: 6,313 S.F. (1,892 S.F.)
 V. EXTERIOR STAIRWAYS: 7,872 S.F.
 VI. TOTAL GROUND FLOOR: 34,454 S.F.
 VII. BASEMENT: 6,118 S.F.
 VIII. UPPER FLOOR: 6,009 S.F.
 IX. MEZZANINE GALLERY DECK O/COLONADE: 8,160 S.F.
 X. TOTAL GROUND FLOOR AREA: 57,791 S.F.
 XI. EXISTING BUILDINGS: 19,180 S.F. (57,791 S.F.)
 XII. TOTAL BLDGS AREA ON SITE: 76,971 S.F.

GROUND FLOOR CONDITIONED SPACE: 16,300 S.F.
RESTROOM ANNEX: 2,077 S.F. (NON CONDITIONED)
COLONADE: 6,313 S.F. (1,892 S.F.)
EXTERIOR STAIRWAYS: 7,872 S.F.
TOTAL GROUND FLOOR: 34,454 S.F.
BASEMENT: 6,118 S.F.
UPPER FLOOR: 6,009 S.F.
MEZZANINE GALLERY DECK O/COLONADE: 8,160 S.F.
TOTAL GROUND FLOOR AREA: 57,791 S.F.
EXISTING BUILDINGS: 19,180 S.F. (57,791 S.F.)
TOTAL BLDGS AREA ON SITE: 76,971 S.F.

WALKWAY NOTES:
 PROVIDE A LEVEL LANDING WITH A SLOPE NOT EXCEEDING 1:48 (2.08%) AT ALL EXTERIOR DOORS AND GATES PER CBC 11B-404.2.4.4 WITH MANEUVERING CLEARANCE EXTENDING 24" MIN.PAST THE STRIKE EDGE FOR A DISTANCE OF 60" MIN.ON THE PULL SIDE OF THE DOOR. FIG. 11B-404.2.4.1 EXTERIOR EXIT DOORS/GATES SHALL LEAD DIRECTLY TO THE PUBLIC WAY BY MEANS OF AN ACCESSIBLE ROUTE.CBC 1020.2.2, 11B-206.2.1

APPLICANT:
 GURUDWARA NANAK SAR
 3360 S. CHERRY AVE.
 FRESNO, CA 93711
 PH: 436-4396
 FAX: 436-4399
 EMAIL: drsrbhal@att.net

NOTES:
 1. ALL DAMAGED AND/OR OFF-GRADE CONCRETE IMPROVEMENTS AS DETERMINED BY THE CONSTRUCTION MANAGEMENT ENGINEER PRIOR TO THE START OF CONSTRUCTION SHALL BE REPAIRED OR REPLACED.
 2. ANY SURVEY MONUMENTS WITHIN THE AREA OF CONSTRUCTION SHALL BE PRESERVED OR RESET BY A PERSON LICENSED TO PRACTICE LAND SURVEYING IN THE STATE OF CALIFORNIA.
 3. A BACKFLOW PREVENTION DEVICE IS REQUIRED TO BE INSTALLED ON-SITE IN A LOCATION APPROVED BY THE CROSS CONNECTION CONTROL OFFICER. A PLUMBING FIRM IS REQUIRED TO INSTALL AND TEST SUCH DEVICES. THE INSTALLATION DEVICES MUST BE INSTALLED ON-SITE AT THE EXPENSE OF THE DEVELOPER. THE WATER DIVISION SHALL BE NOTIFIED PRIOR TO GRANTING FINAL DEVELOPER IS RESPONSIBLE TO CONTACT THE WATER DIVISION A MINIMUM OF 5 WORKING DAYS PRIOR TO REQUEST FOR FINAL BUILDING INSPECTION.
 4. ALL EXISTING DRIVEWAY APPROACHES WHICH NO LONGER PROVIDE ACCESS TO APPROVED VEHICLES SHALL BE REMOVED. UNLESS OTHERWISE APPROVED BY THE CITY ENGINEER, SUCH AREAS SHALL BE RECONSTRUCTED WITH CURBS, GUTTER AND SIDEWALK TO MATCH EXISTING ADJACENT STREET IMPROVEMENTS. THIS WORK SHALL BE COMPLETED AND ACCEPTED BEFORE A PERMIT OF OCCUPANCY IS ISSUED OR THE BUILDING IS OCCUPIED.
 5. ANY UTILITIES REQUIRING RELOCATION SHALL BE THE RESPONSIBILITY AND AT THE EXPENSE OF THE DEVELOPER. FIRE HYDRANTS WILL BE RELOCATED BY CITY ENGINEER. DEVELOPER IS RESPONSIBLE TO NOTIFY CITY WATER DIVISION TO ARRANGE AND COORDINATE WORK AT 921-5300.

6. TWO MEANS OF EGRESS/INGRESS SHALL BE MAINTAINED DURING ALL PHASES OF DEVELOPMENT.
 7. PROVIDE SIGN (17"x22" MIN.) AT ALL PUBLIC ENTRANCE DRIVES TO THE PROPERTY. EXISTING WARNING VEHICLES STOPPED, PARKED, OR LEFT STANDING IN FIRE LINES WILL BE IMMEDIATELY REMOVED AT OWNER'S EXPENSE. POLICE OFFICER.
 8. ALL CONSTRUCTION WORK OF THIS PROJECT IS SUBJECT TO INTERRUPTION IF THE ROAD SYSTEM BECOMES IMPASSABLE FOR FIRE APPARATUS DUE TO RAIN OR OTHER OBSTACLES.
 9. FIRE HYDRANTS SHALL BE TESTED, PAINTED, NUMBERED AND APPROVED AND ALL SURFACE ACCESS ROADS SHALL BE INSTALLED AND MADE SERVICEABLE PRIOR TO AND DURING THE TIME OF CONSTRUCTION.
 10. SUBMIT STREET LIGHTING PLANS TO TRAFFIC ENGINEERING/PUBLIC WORKS DEPARTMENT. OPTIONAL.
 11. SUBMIT LANDSCAPE PLANS TO PUBLIC WORKS, ENGINEERING SERVICES DEPARTMENT.
 12. OPEN CUT IS NOT PERMITTED. ALL UTILITIES CONNECTIONS MUST BE BORDED. SURFACE DRAINAGE OVER DRIVEWAY APPROACHES AND SIDEWALKS IS NOT ALLOWED WHEN THE AREA BEING DRAINED EXCEEDS 1/4 ACRE. SHOW METHOD OF CONVEYING ON-SITE STORM WATER TO STREET. DETAIL CATCH BASINS AND PIPE OR CHANNEL SIZE TO BE USED PER F.W. STD. P-22.
 13. CONSTRUCT CONCRETE SIDEWALKS, CURBS, GUTTERS AND DRIVEWAY APPROACHES TO MEET PUBLIC WORKS STANDARD SPECIFICATIONS P-2, P-5 & P-6 (IF NOT EXISTING).
 14. NO USES OF LAND, BUILDINGS OR STRUCTURES OTHER THAN THOSE SPECIFICALLY APPROVED PURSUANT TO THIS SITE PLAN SHALL BE PERMITTED. CITY ENGINEER AND THE TOW AWAY MARKING SHALL BE POSTED CONSPICUOUSLY ON 7-FOOT POLES.

15. NO STRUCTURES OF ANY KIND MAY BE INSTALLED OR MAINTAINED WITHIN THE LANDSCAPED SETBACK AREAS.
 16. NO EXPOSED UTILITIES BOXES, TRANSFORMERS, METERS, PIPING, (EXCEPTING THE BACKFLOW PREVENTION DEVICES) ETC. ARE ALLOWED TO BE LOCATED IN THE LANDSCAPED AREAS OR SETBACKS OR ON THE STREET FRONTS OF THE BUILDINGS. ALL TRANSFORMERS, ETC. SHALL BE SHOWN ON THE SITE PLAN. THE BACKFLOW DEVICE SHALL BE SCREENED BY LANDSCAPING OR SUCH OTHER MEANS AS MAY BE APPROVED BY THE CITY ENGINEER.
 17. TREES SHALL BE MAINTAINED IN GOOD HEALTH. HOWEVER, TREES MAY NOT BE TRIMMED OR PRUNED TO REDUCE THE NATURAL HEIGHT OR OVERALL SPREAD OF THE TREE EXCEPT AS NECESSARY FOR THE HEALTH OF THE TREE AND PUBLIC SAFETY, OR AS MAY OTHERWISE BE APPROVED BY THE DEVELOPMENT DEPARTMENT. PROVIDE LANDSCAPING PLAN.
 18. LANDSCAPING MUST BE IN PLACE BEFORE THE ISSUANCE OF THE CERTIFICATE OF OCCUPANCY. A HOLD ON OCCUPANCY SHALL BE PLACED ON THE PROPOSED DEVELOPMENT UNTIL SUCH TIME THAT LANDSCAPING HAS BEEN APPROVED AND VERIFIED FOR PROPER INSTALLATION BY THE DEVELOPMENT DEPARTMENT.
 19. TO FINAL INSPECTION, A WRITTEN CERTIFICATION, SIGNED BY A LANDSCAPE PROFESSIONAL APPROVED BY THE DIRECTOR, SHALL BE SUBMITTED STATING THAT THE REQUIRED LANDSCAPING AND IRRIGATION SYSTEM WAS INSTALLED IN ACCORDANCE WITH THE DESIGN AND INSTALLATION PLANS AND THAT THE LANDSCAPING AND IRRIGATION SYSTEMS MEET ALL REQUIREMENTS OF THE APPROVED TRANSPORTATION MANAGEMENT PLAN AND THE ELEVATIONS, FOR THE EXTERIOR OF ALL BUILDINGS AND STRUCTURES.
 20. ALL ACCESSIBLE PARKING STALLS SHALL BE MARKED WITH THE INTERNATIONAL SYMBOL OF ACCESSIBILITY AND A WARNING THAT VEHICLES IN VIOLATION OF SECTION 11B-404.2.4.1 SHALL BE TOWED AWAY. THE ACCESSIBILITY SYMBOL AND THE TOW AWAY MARKING SHALL BE POSTED CONSPICUOUSLY ON 7-FOOT POLES.

21. ALL ACCESSIBLE PARKING STALLS SHALL BE PLACED ADJACENT TO FACILITY ACCESS RAMPS OR IN STRATEGIC AREAS WHERE THE DISABLED SHALL NOT HAVE TO WHEEL OR WALK BEHIND PARKED VEHICLES WHILE TRAVELING TO OR FROM ACCESSIBLE PARKING STALLS AND RAMP.
 22. IF ARCHAEOLOGICAL AND/OR ANIMAL FOSSIL MATERIAL IS ENCOUNTERED DURING PROJECT SURVEYING, GRADING, EXCAVATING, OR CONSTRUCTION, WORK SHALL BE STOPPED IMMEDIATELY.
 23. IF THERE ARE SUSPECTED HUMAN REMAINS, THE FRESNO COUNTY CORONER SHALL BE IMMEDIATELY CONTACTED. IF THE REMAINS OR OTHER ARCHAEOLOGICAL MATERIAL IS POSSIBLY NATIVE AMERICAN OR OTHER ARCHAEOLOGICAL MATERIAL, THE NATIVE AMERICAN HERITAGE COMMISSION SHALL BE CONTACTED IMMEDIATELY AT (916) 683-4082 AND THE CALIFORNIA ARCHAEOLOGICAL INVENTORY SOUTHERN SAN JOAQUIN VALLEY INFORMATION CENTER SHALL BE CONTACTED AT (800)844-2289 TO OBTAIN A LIST OF RECOGNIZED ARCHAEOLOGISTS. AN ARCHAEOLOGICAL ASSESSMENT SHALL BE CONDUCTED FOR THE PROJECT. THE SITE SHALL BE FORMALLY RECORDED, AND THE RECOMMENDATIONS MADE TO THE CITY AS TO ANY FURTHER SITE INVESTIGATION OR SITE AVOIDANCE PRESERVATION.
 24. IF ANIMAL REMAINS ARE UNCOVERED, THE RECORDS OF PALEONTOLOGY, U.S. BUREAU OF LAND MANAGEMENT SHALL BE CONTACTED TO OBTAIN REFERRAL LIST OF RECOGNIZED PALEONTOLOGISTS. AN ASSESSMENT SHALL BE CONDUCTED BY A PALEONTOLOGIST AND IF THE PALEONTOLOGIST DETERMINES THE MATERIAL TO BE SIGNIFICANT, IT SHALL BE PRESERVED.
 25. IN ACCORDANCE WITH THE CALIFORNIA INTEGRATED WASTE MANAGEMENT BOARD MODEL ORDINANCE.
 26. CONTACT SOLID WASTE DEPARTMENT FOR APPROPRIATE TO BE TYPED, TABSH ACCESS AND IMPROVEMENTS REQUIRED AS CONDITIONS OF PERMITTING.
 27. STREET IMPROVEMENTS REQUIRED. SUBMIT ENGINEER STREET CONSTRUCTION PLANS TO P.W.

28. REFER WALKWAY NOTE # 1 BOTTOM LEFT CORNER FOR HATCHED AREA REQUIREMENT (5'x5').
 29. PROPOSED NEW POOL PARKING (SHALL BE MARKED WITH SIGNS RESTRICTING THEIR USE TO CLEAN CAR PARKING)
 30. EXISTING PROPERTY CORNER EXISTING PROPOSED/NEW RELOCATED RESERVED FOR ELECTRIC CAR PARKING
 31. REFER WALKWAY NOTE # 1 BOTTOM LEFT CORNER FOR HATCHED AREA REQUIREMENT (5'x5').
 32. PROPOSED NEW POOL PARKING (SHALL BE MARKED WITH SIGNS RESTRICTING THEIR USE TO CLEAN CAR PARKING)
 33. EXISTING PROPERTY CORNER EXISTING PROPOSED/NEW RELOCATED RESERVED FOR ELECTRIC CAR PARKING

34. STREET LIGHT PROVIDED TO ILLUMINATE PARKING, SALES OR DISPLAY AREAS SHALL BE HOODED AND SO ARRANGED AND CONTROLLED SO AS NOT TO CAUSE A NUISANCE EITHER TO HIGHWAY TRAFFIC OR TO THE LIVING ENVIRONMENT. THE AMOUNT OF LIGHT SHALL BE PROVIDED ACCORDING TO THE STANDARDS OF THE DEPT. OF PUBLIC WORKS.
 35. SIGNS OTHER THAN DIRECTIONAL ARE NOT APPROVED FOR INSTALLATION AS PART OF THIS SPECIAL PERMIT. SUBMIT FOR SEPARATE SIGN REVIEW.
 36. WINDOW SIGNS ARE LIMITED TO 4 SQUARE FEET IN AREA. PROVIDING INFORMATION ABOUT HOURS OF OPERATION AND EMERGENCY SALE OR RENTAL INFORMATION ONLY. EXTERIOR SIGNAGE MANUFACTURING SPECIFICATIONS SHALL BE SUBMITTED TO THE CITY AS TO ANY FURTHER SITE INVESTIGATION FOR 30 DAYS IF APPROVED BY THE DEVELOPMENT DIRECTOR, ATTACHED TO THE BUILDING AND NOT EXCEEDING 32 S.F. IN AREA.
 37. ALL REQUIREMENTS OF THE APPROVED TRANSPORTATION MANAGEMENT PLAN AND THE ELEVATIONS, FOR THE EXTERIOR OF ALL BUILDINGS AND STRUCTURES.
 38. ROOF STRUCTURES AND DETACHED MECHANICAL EQUIPMENT FOR COMM'L. AND OFFICE USES SHALL BE SCREENED FROM VIEW AND ADJACENT AREAS BY USING DISPOSAL DEVICES OR EQUIPMENT TO PREVENT THE EQUIPMENT FROM EXCEEDING 5'6" MEASURED AT THE NEAREST PROPERTY LINE.

LEGEND:
 EXISTING PROPERTY CORNER EXISTING PROPOSED/NEW RELOCATED RESERVED FOR ELECTRIC CAR PARKING
 REFER WALKWAY NOTE # 1 BOTTOM LEFT CORNER FOR HATCHED AREA REQUIREMENT (5'x5').
 PROPOSED NEW POOL PARKING (SHALL BE MARKED WITH SIGNS RESTRICTING THEIR USE TO CLEAN CAR PARKING)
 EXISTING PROPERTY CORNER EXISTING PROPOSED/NEW RELOCATED RESERVED FOR ELECTRIC CAR PARKING


STREET LIGHT PARKING STALL WROUGHT IRON FENCE EXISTING (TO REMAIN) PROPOSED/NEW EXISTING TO BE REMOVED PROPERTY LINE/R.O.W. LINE
 P.P. POWER POLE
 L.P. LANDSCAPING
 (N) WATER LINE
 (S) SEWER LINE
 (N) FIRE SERVICE LINE
 (S) FIRE SERVICE LINE
 ACC. AISLE & ROUTE NO PARKING ZONE

WORKING DAYS BEFORE COMMENCING EXCAVATION OPERATIONS WITHIN THE STREET RIGHT-OF-WAY AND/OR UTILITY EASEMENTS, ALL EXISTING UNDERGROUND UTILITIES SHALL HAVE BEEN LOCATED BY UNDERGROUND SERVICES ALERT (USA). CALL 1-800-642-2444.
 CONTACT PUBLIC WORKS DEPT. TRAFFIC ENGINEERING, (559) 621-8800, TO WORKING DAYS PRIOR TO ANY OFFSITE CONCRETE CONSTRUCTION.
 UNDERGROUND ALL EXISTING OFFSITE OVERHEAD UTILITIES WITHIN THE LIMITS OF THIS SITE/MAP AS PER SECTION 15-2017 (DEETS) OF EASEMENTS) FOR THE REQUIRED DEDICATION(S) SHALL BE PREPARED BY THE OWNER/DEVELOPER'S ENGINEER AND SUBMITTED TO THE CITY WITH VERIFICATION OF OCCUPANCY PRIOR TO ISSUANCE OF BUILDING PERMITS.
 THE REQUIRED 4" MINIMUM PATH OF TRAVEL SHALL BE PROVIDED ALONG UNDERGROUND UTILITIES DIRECTLY IN FRONT OF PROPERTY AS REQUIRED BY THE CALIFORNIA ADMINISTRATION CODE (TITLE 24). A PEDESTRIAN GASEMENT MAY BE REQUIRED IF THE UTILITY DEPT. ENGINEER DOES NOT MEET THE WALKING SURFACE OF THE ACCESSIBLE ROUTE SHALL HAVE A SLOPE NOT TO EXCEED 1:48 OR A CROSS SLOPE OF 2% AS PER CBC 11B-404.2.4.4.
 FUTURE PERMITS SHALL BE REVIEWED AND APPROVED BY DIRM DEPARTMENT PRIOR TO INSTALLATION.
 SUBJECT PROPERTIES SHALL NOT EXCEED 50 DEGREES FROM 7 P.M. TO 10 P.M. AND 15 DEGREES FROM 7 A.M. TO 8 DEGREES FROM 7 P.M. TO 7 A.M.
 ALL FUTURE PERMITS SHALL BE REVIEWED AND APPROVED BY DIRM DEPARTMENT PRIOR TO INSTALLATION.
 FUTURE PERMITS SHALL NOT EXCEED 50 DEGREES FROM 7 P.M. TO 10 P.M. AND 15 DEGREES FROM 7 A.M. TO 8 DEGREES FROM 7 P.M. TO 7 A.M.
 ALL FUTURE PERMITS SHALL BE REVIEWED AND APPROVED BY DIRM DEPARTMENT PRIOR TO INSTALLATION.
 FUTURE PERMITS SHALL NOT EXCEED 50 DEGREES FROM 7 P.M. TO 10 P.M. AND 15 DEGREES FROM 7 A.M. TO 8 DEGREES FROM 7 P.M. TO 7 A.M.

REVISIONS:	DATE
1. RELOCATED TRANSFORMER	05.25.22

ACE Design LLC
 1024 Iron Point Road, SUITE 1046
 Folsom, CA 95630
 Phone: (702) 396-5113, Fax: (702) 446-8155
 Land Planning • Civil Engineering • Architectural Design • Structural Engineering

SITE PLAN
GURUDWARA NANAKSAR
 3060 S. CHERRY AVE.
 FRESNO, CA 93706

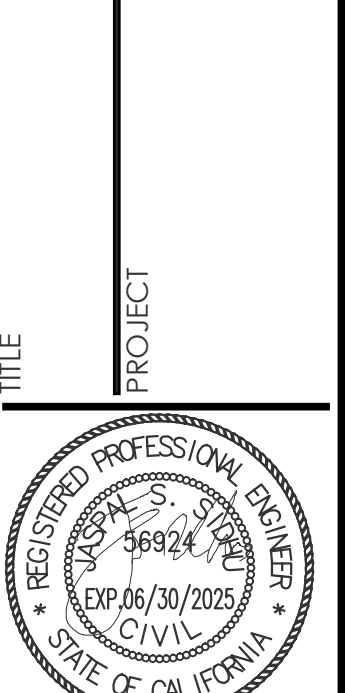

DATE: 03/29/2024
 JOB: 17-41
 DWG. BY: HS
 CHK. BY: MG
A1.0.0
 SHEET
 7 OF 44