

ELEVATION FOR MARKETPLACE AT EL PASEO – PHASE 2



E-1



EXTERIOR ELEVATIONS- THEATER, SHOPS 6 & 7, RETAIL 2

MARKETPLACE AT EL PASEO
SEC RIVERSIDE & HERNDON AVE.
FRESNO, CALIFORNIA

DATE: MARCH 31, 2017
NADEL JOB#: 10075
NADEL RETAIL ARCHITECTS, LLP
1990 S. BUNNY DR., FOURTH FLOOR
LOS ANGELES, CA 90025
T.310.826.2100 F.310.826.0182
WWW.NADELARC.COM

NADEL

ALL DRAWINGS AND WRITTEN MATERIAL APPEARING HEREIN CONSTITUTE THE ORIGINAL AND UNPUBLISHED WORK OF THE ARCHITECT AND THE SAME MAY NOT BE REPRODUCED, USED OR DISCLOSED WITHOUT THE WRITTEN CONSENT OF THE ARCHITECT. COPYRIGHT NADEL RETAIL ARCHITECTS, LLP. ALL RIGHTS RESERVED.

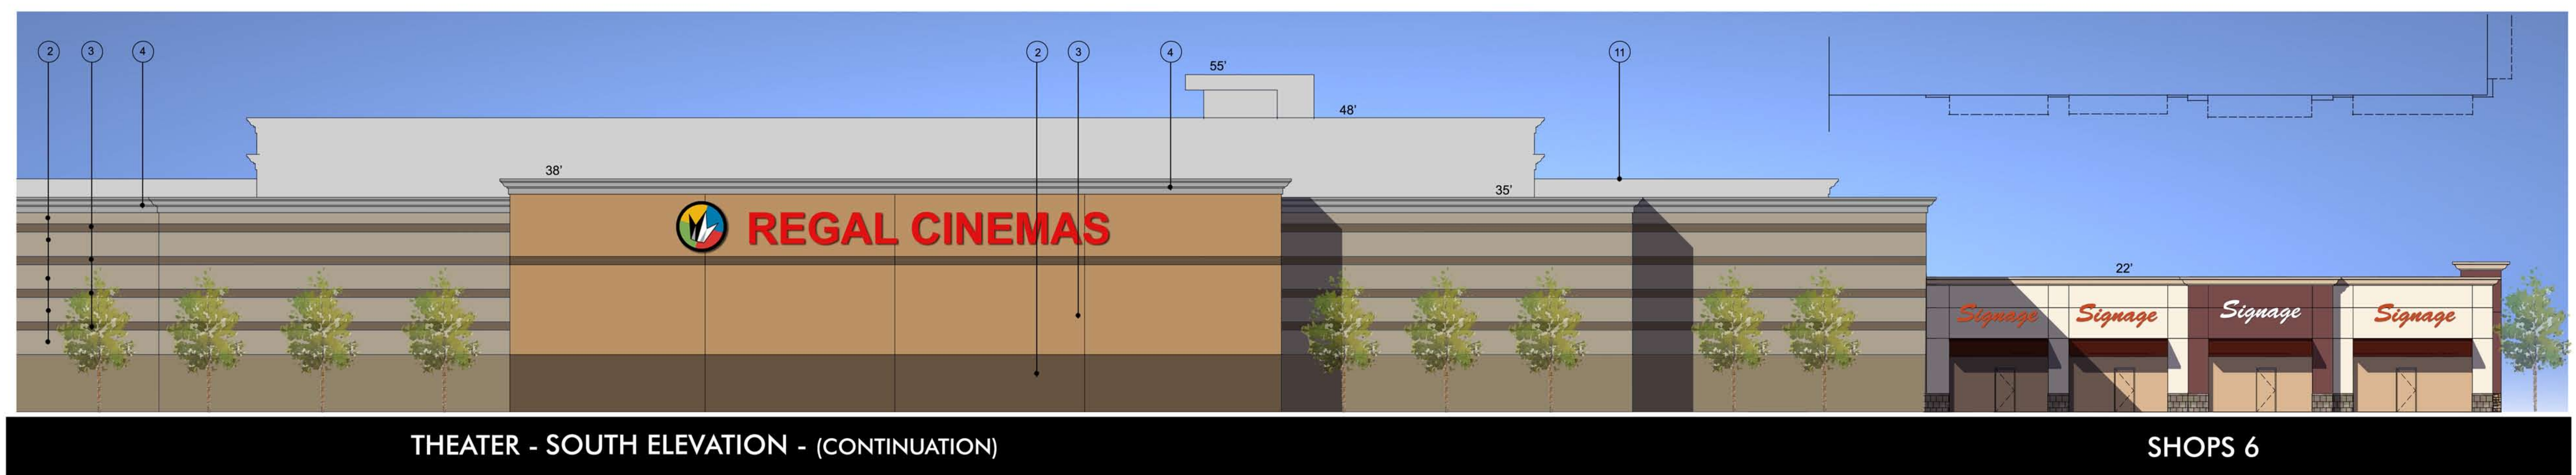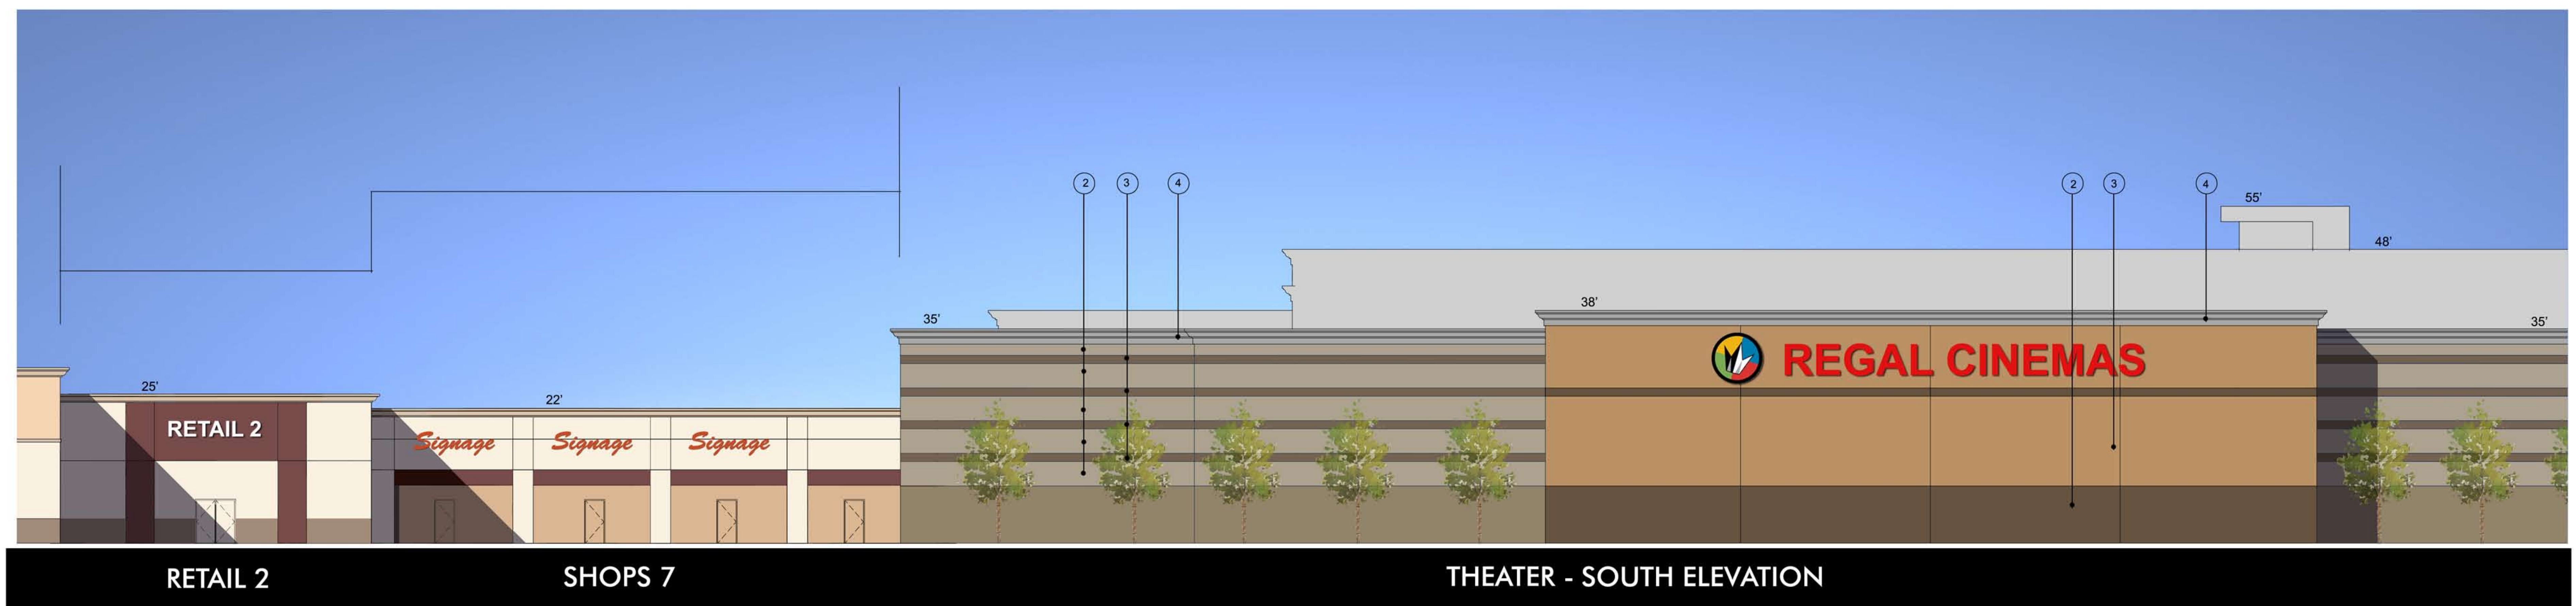

EXTERIOR ELEVATIONS- THEATER, SHOPS 6 & 7, RETAIL 2


MARKETPLACE AT EL PASEO
SEC RIVERSIDE & HERNDON AVE.
FRESNO, CALIFORNIA

DATE: MARCH 31, 2017
NADEL JOB#: 15075

NADEL RETAIL ARCHITECTS, LLP
1990 S. BUNDY DR., FOURTH FLOOR
LOS ANGELES, CA. 90025
T.310.826.2100 F.310.826.0182
WWW.NADELARC.COM

E-2

NADEL

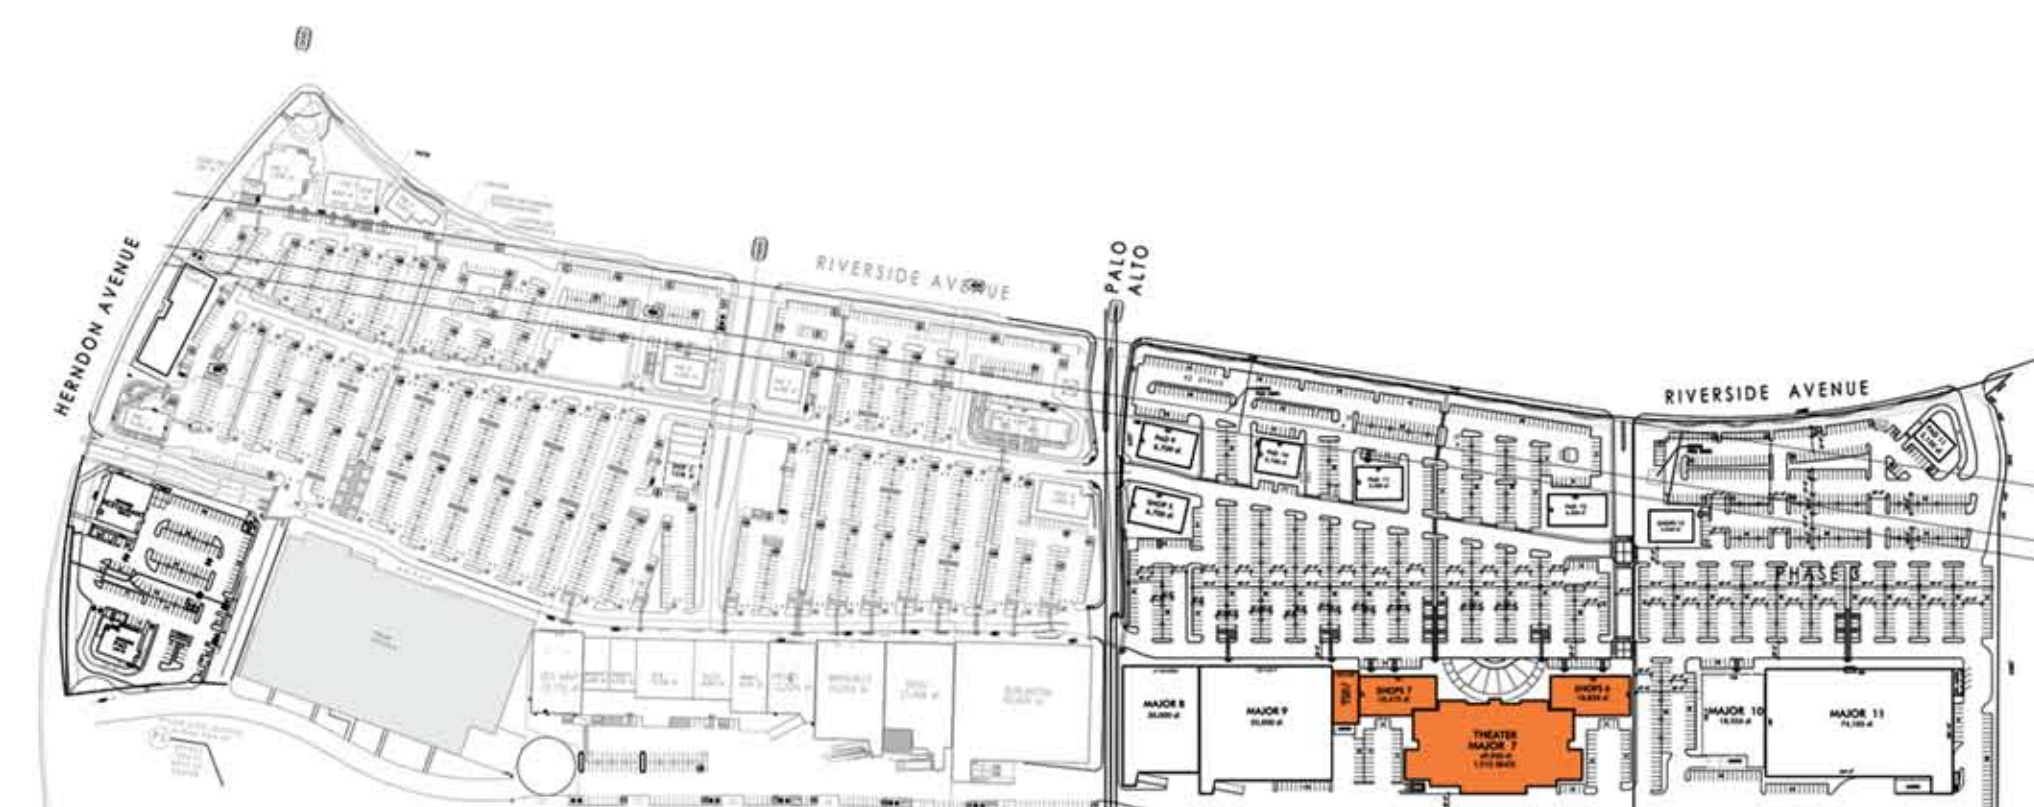

- LEGEND:**
- 1. PLASTER OR EIFS FINISH
 - 2. SPLIT FACE BLOCKS
 - 3. PRECISION BLOCKS
 - 4. EIFS CORNICE
 - 5. COMPOSITE METAL PANEL
 - 6. DECORATIVE LIGHTING
 - 7. METAL CANOPY
 - 8. MOVIE POSTERS
 - 9. STONE VENEER
 - 10. OUTLINE OF FOREGROUND SHOPS
 - 11. BUILDING BEYOND
 - 12. STEEL TRELLIS
 - 13. FABRIC AWNING

EXTERIOR ELEVATIONS- THEATER, SHOPS 6 & 7, RETAIL 2


MARKETPLACE AT EL PASEO
 SEC RIVERSIDE & HERNDON AVE.
 FRESNO, CALIFORNIA

DATE: MARCH 31, 2017
 NADEL JOB#: 15075


NADEL RETAIL ARCHITECTS, LLP
 1990 S. BUNDY DR., FOURTH FLOOR
 LOS ANGELES, CA. 90025
 T.310.826.2100 F.310.826.0182
 WWW.NADELARC.COM

E-3


NADEL

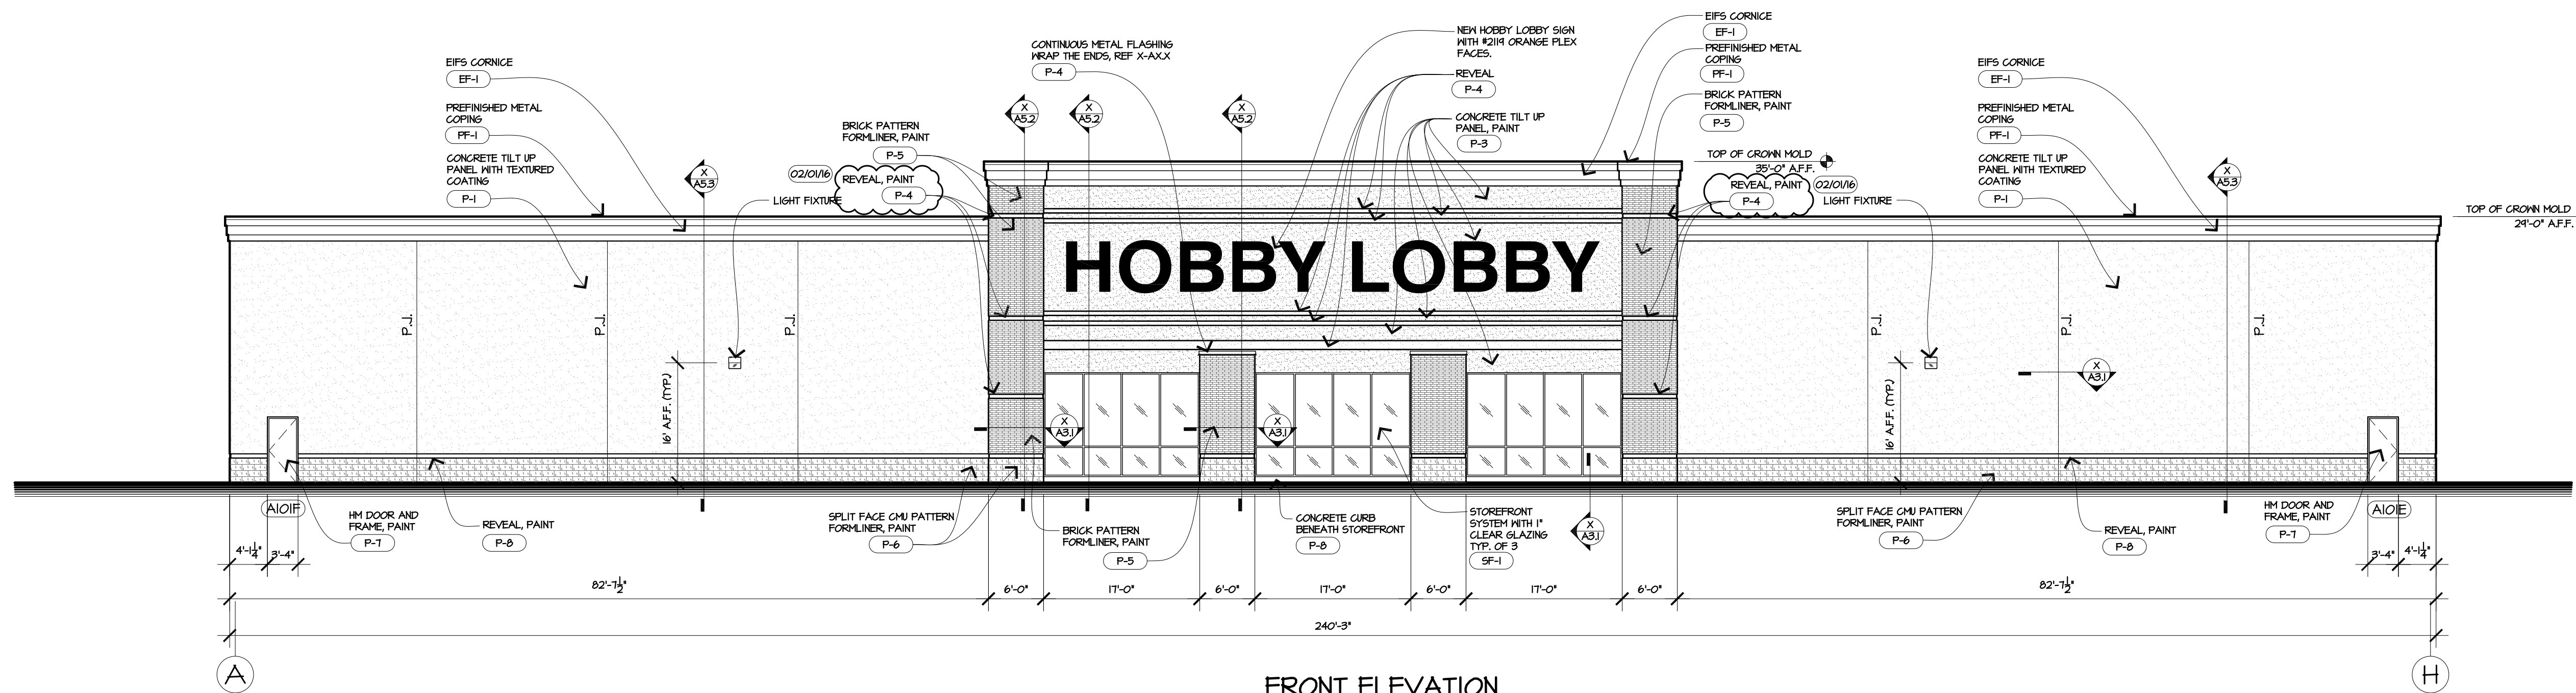


FRONT ELEVATION
ELEVATION HEIGHT MAY GO UP AS REQUIRED BY ROOF SLOPE.
SIGN SHOWN IS PRELIMINARY. SIGN SHALL BE UNDER A SEPARATE SUBMITTAL.

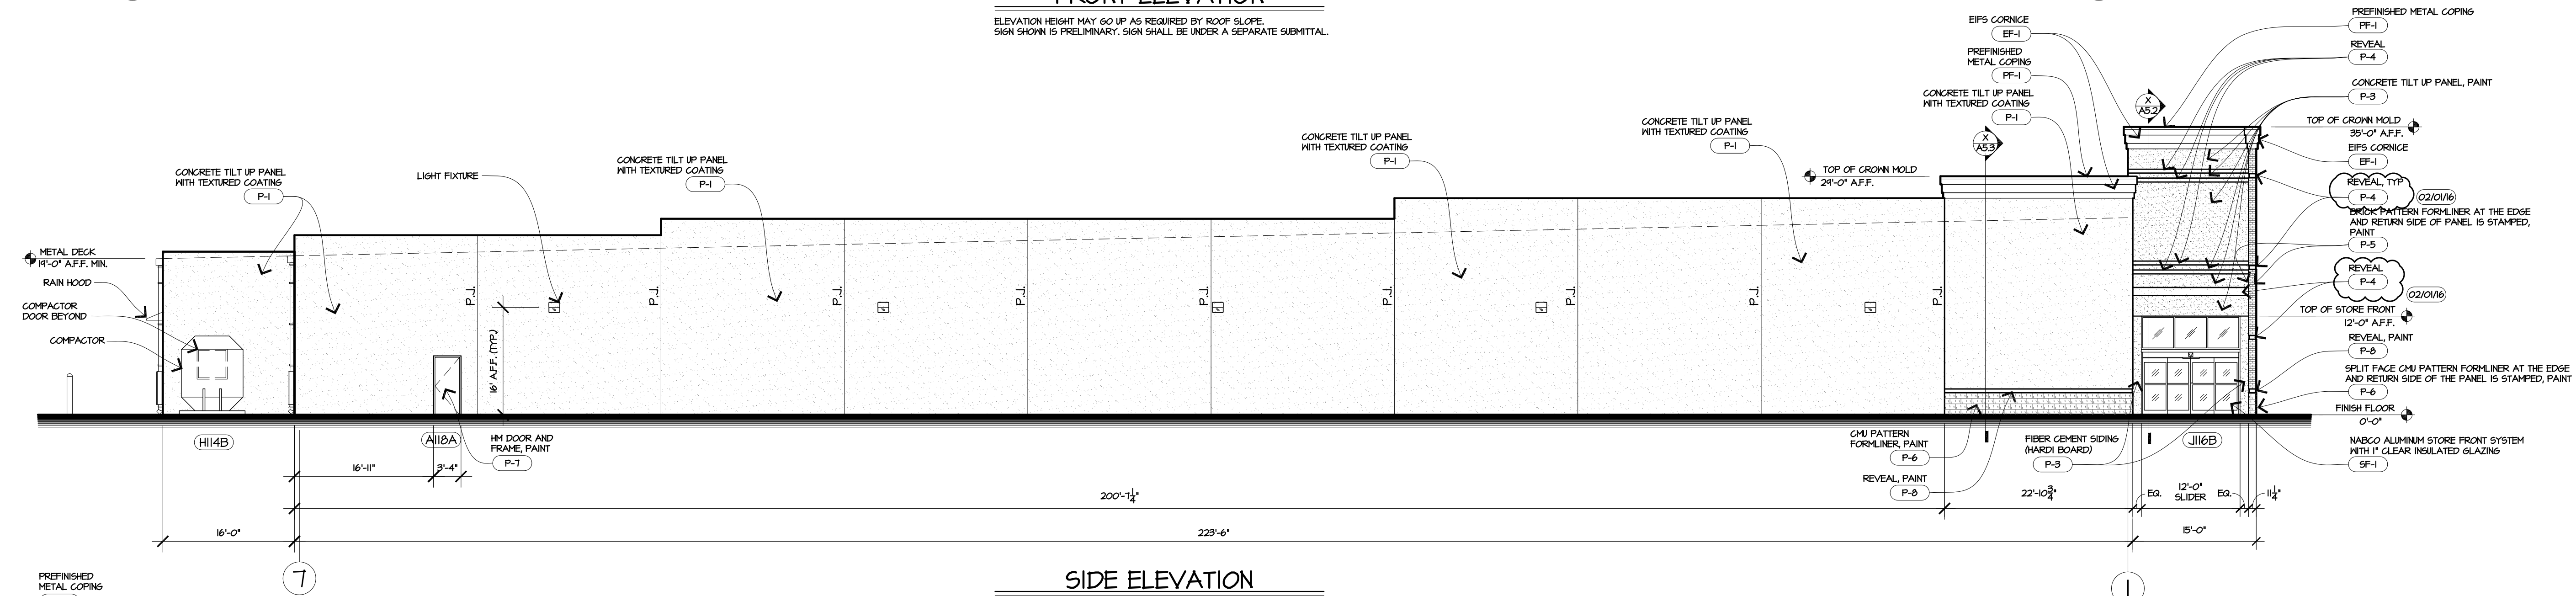

SIDE ELEVATION
ELEVATION HEIGHT MAY GO UP AS REQUIRED BY ROOF SLOPE.
SIGN SHOWN IS PRELIMINARY. SIGN SHALL BE UNDER A SEPARATE SUBMITTAL.

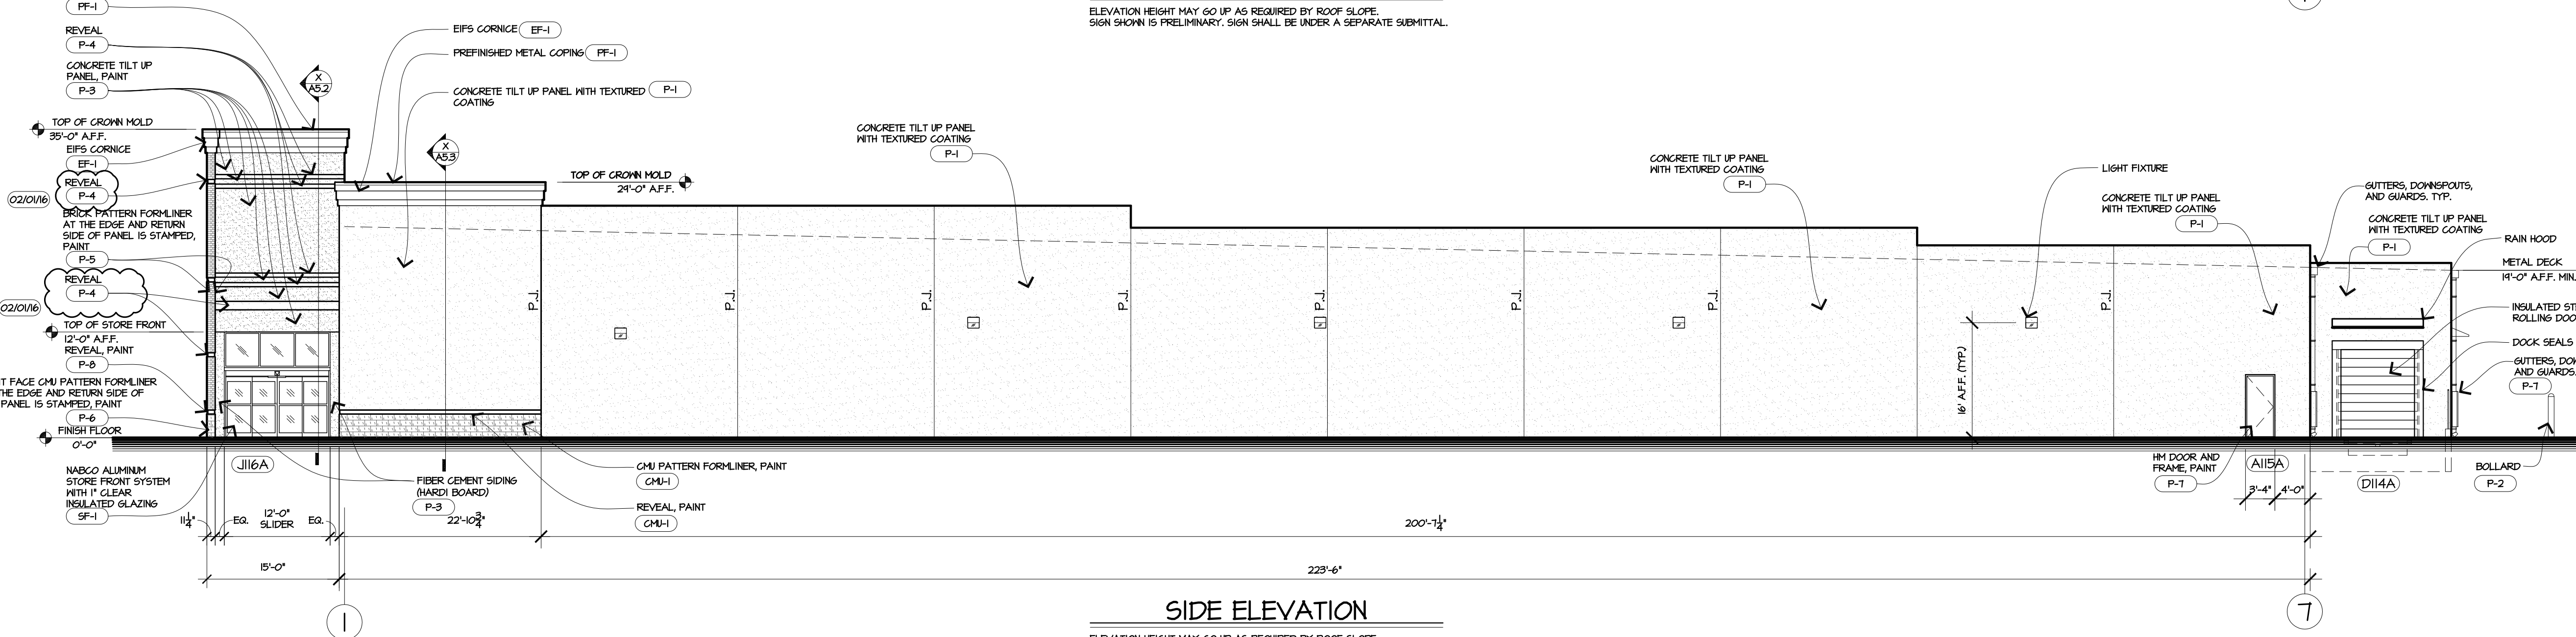

SIDE ELEVATION
ELEVATION HEIGHT MAY GO UP AS REQUIRED BY ROOF SLOPE.
SIGN SHOWN IS PRELIMINARY. SIGN SHALL BE UNDER A SEPARATE SUBMITTAL.

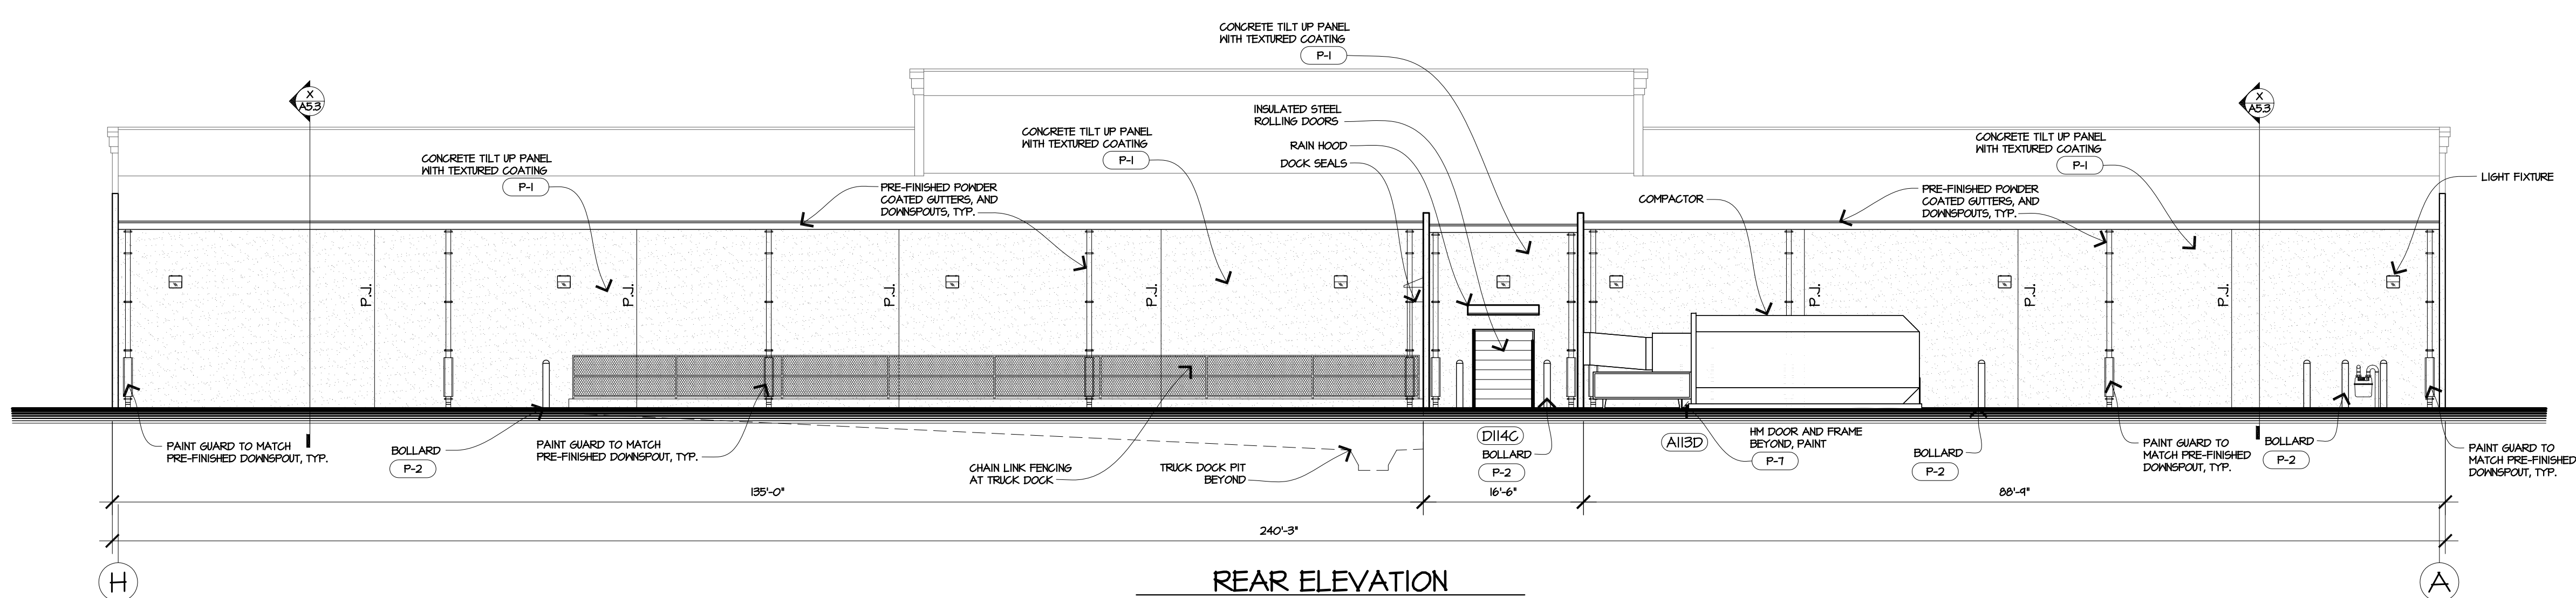

REAR ELEVATION
ELEVATION HEIGHT MAY GO UP AS REQUIRED BY ROOF SLOPE.
SIGN SHOWN IS PRELIMINARY. SIGN SHALL BE UNDER A SEPARATE SUBMITTAL.

EXTERIOR MATERIALS LEGEND					
MARK	MATERIAL	MANUFACTURER	MODEL/STYLE	COLOR	REMARKS
EF-1	EPS	DRYVIT	PB SYSTEM	SN 1551 "GREEK VILLA" [1]	SAND FINISH
PF-1	PREFINISHED METAL	HICKMAN	TERMINEDGE TE-625	A-12 "ASCOT WHITE"	250 ALUMINUM
SF-1	STOREFRONT SYSTEM	KANNEER	451 SERIES	"DARK BRONZE"	ANODIZED ALUMINUM
P-1	PAINT	SHERWIN-WILLIAMS	ULTRA-CRETE	SN 1506 "LOGGIA"	MEDIUM TEXTURE
P-2	PAINT	SHERWIN-WILLIAMS	ADM-100 SERIES	SN 4084 "SAFETY YELLOW"	BOLLARDS
P-3	PAINT	SHERWIN-WILLIAMS	ULTRA-CRETE	SN 1504 "TISKI HIT"	MEDIUM TEXTURE
P-4	PAINT	SHERWIN-WILLIAMS	ADM-100 SERIES	SN 1551 "GREEK VILLA"	MEDIUM TEXTURE
P-5	PAINT	SHERWIN-WILLIAMS	ULTRA-CRETE	SN 6049 "TERRA BRUN"	NO TEXTURE
P-6	PAINT	SHERWIN-WILLIAMS	ULTRA-CRETE	SN 1024 "FUNCTIONAL GRAY"	NO TEXTURE
P-7	PAINT	SHERWIN-WILLIAMS	ADM-100 SERIES	SN 1506 "LOGGIA" [2]	SEMI-GLOSS
P-8	PAINT	SHERWIN-WILLIAMS	ULTRA-CRETE	SN 1024 "FUNCTIONAL GRAY"	MEDIUM TEXTURE

- NOTES:
1. COLORS NOTED ABOVE FOR EPS ARE SHERWIN-WILLIAMS COLORS - EPS TO MATCH THOSE COLORS.
2. P-1 FOR ALL DOWNPOUTS, GUTTERS AND DOWNPOUT GUARDS UNLESS NOTED OTHERWISE.
3. PAINT COLORS FOR ALL EXTERIOR STEEL DOORS AND FRAMES TO MATCH ADJACENT COLORS UNLESS NOTED OTHERWISE.
4. SIGNAGE TO BE SUBMITTED UNDER SEPARATE PERMIT FROM BUILDING.
5. ALL PAINTED EXTERIOR TILT-UP WALL SURFACES TO RECEIVE "ULTRA-CRETE" COMMERCIAL APPLICATION PER MANUFACTURERS RECOMMENDATIONS AND PROCEDURES PRIOR TO APPLICATION OF FINAL FINISH COLORS.
6. GC TO OBTAIN HOBBY LOBBY APPROVAL ON MANUFACTURERS AND PATTERNS FOR BRICK AND SPLIT-FACE CMU FORMLINERS.

ARCHITECTURAL LEGEND	
SYMBOL	DESCRIPTION
	DOOR TAG (COORDINATE WITH DOOR SCHEDULE) FIRST LETTER IS DOOR TYPE, THE NUMBER IS THE ROOM NUMBER AND THE LAST LETTER IS THE DOOR IDENTIFICATION FOR THE IDENTIFIED ROOM
	DETAIL NUMBER
	SHEET NUMBER

NOTE:
GC TO OBTAIN HOBBY LOBBY APPROVAL ON MANUFACTURERS AND PATTERNS OF BRICK AND SPLIT-FACE CMU FORMLINERS.

EACH SUBCONTRACTOR SHALL TURN IN A SET OF AS-BUILTS FOR THEIR WORK FOR THE SUPERINTENDENT TO TURN IN TO CONSTRUCTION DESIGN AND DEVELOPMENT DEPARTMENT.

HOBBY LOBBY
Design and Development
7707 S.W. 44th St. Oklahoma City, OK 73179
Phone: -
Scale: -
Drawn by: -
Store address: -

Date: -
Fax: (405) 745-1172

STORE NO.

A3.0

ARCHITECTURAL ELEVATIONS