


FLOOR PLAN KEY NOTES	
Name	NOTE
002	CONCRETE DRIVE (BY OTHERS)
003	CONCRETE WALK (BY OTHERS)
004	CONCRETE PORCH SLAB (BY OTHERS) SLOPE 1/4" PER FOOT MINIMUM IN DIRECTION INDICATED
005	CONCRETE GARAGE SLAB - SLOPE 1/2" PER FOOT MINIMUM IN DIRECTION INDICATED
421	STUCCO CEILING HEIGHT PER PLAN
422	STUCCO SUFFR: HEIGHT PER PLAN
551	MANUFACTURED ADHERED STUCCO STONE VENEER - INSTALL PER MANUFACTURERS INSTRUCTIONS. BY EL DORADO STONE ICC-ES E-3568




WILSON HOMES

TRACT NUMBER: 6168  
 PROJECT TYPE

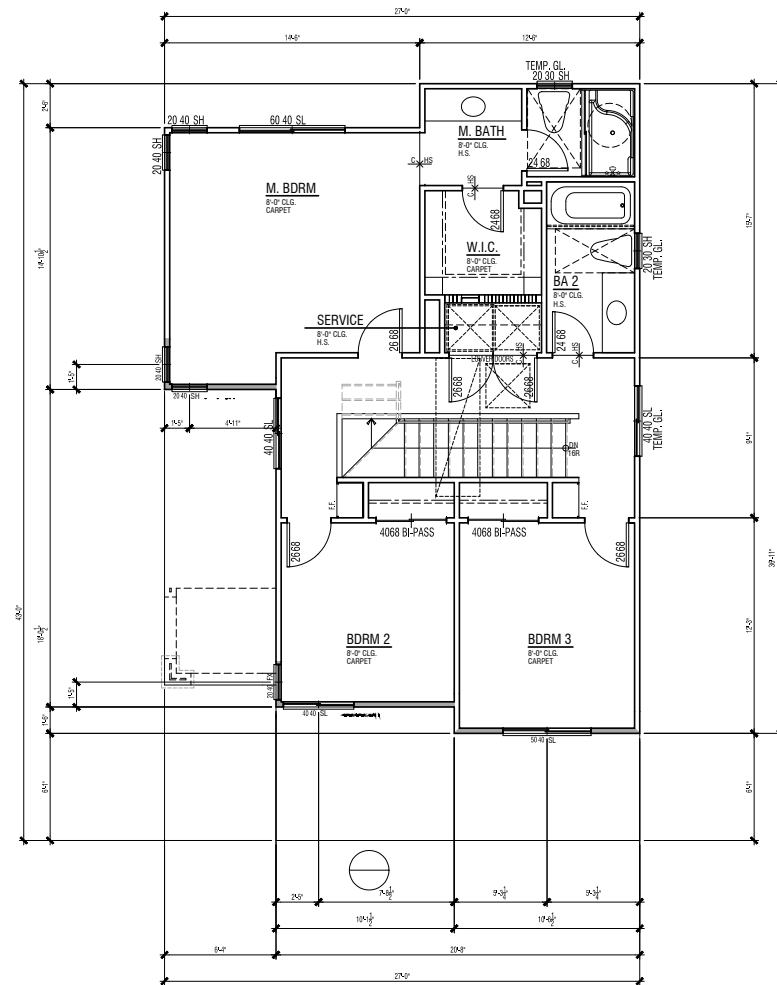

UPPER FLOOR PLAN

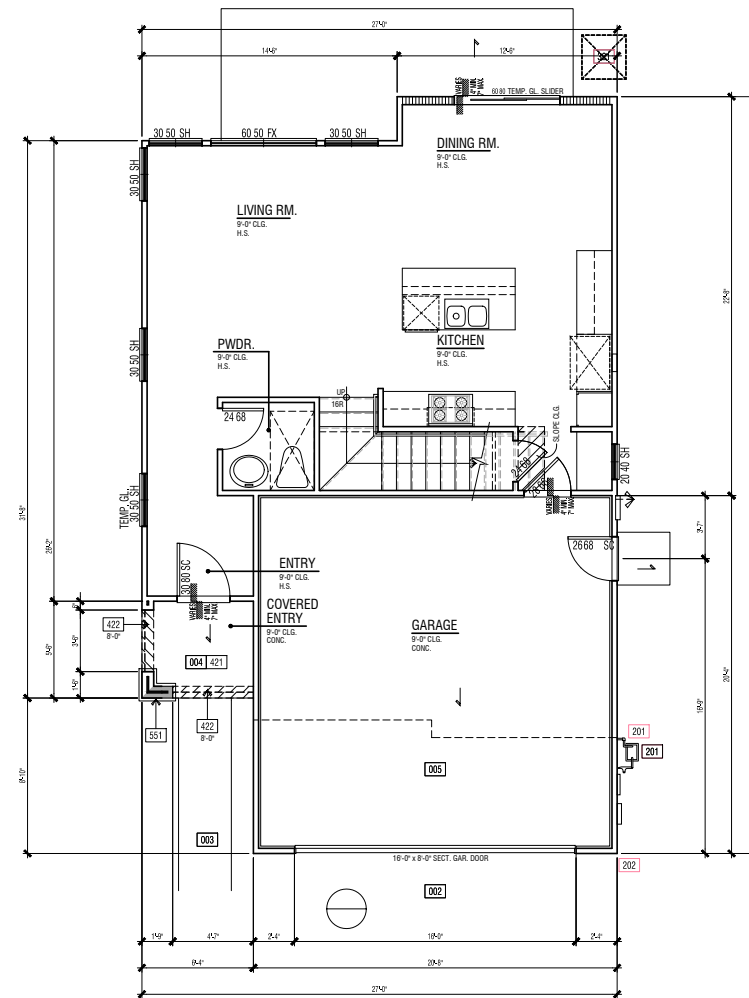

LOWER FLOOR PLAN

**ADDENDA FLOOR PLAN NOTES**  
 NOTE: SHADED WALLS INDICATE AREAS THAT ARE DIFFERENT THAN THE BASE FLOOR PLAN  
 NOTE: REFER TO CIVIL AND LANDSCAPE DRAWINGS BY OTHERS FOR ALL DRIVEWAYS AND SIDEWALK LOCATIONS.  
 REFER TO BASE PLAN SHEET A1.1 FOR ADDITIONAL NOTES AND DIMENSIONS.



INTERIOR ELEVATION KEY

APPL. NO. P19-06281 EXHIBIT F-1 DATE 07/27/18  
 PLANNING REVIEW BY \_\_\_\_\_ DATE \_\_\_\_\_  
 TRAFFIC ENG. \_\_\_\_\_ DATE \_\_\_\_\_  
 APPROVED BY \_\_\_\_\_ DATE \_\_\_\_\_  
 CITY OF FRESNO DARM DEPT

FLOOR AREA TABLE	PLAN 1396B
LOWER FLOOR PLAN	616 SQ. FT.
UPPER FLOOR PLAN	780 SQ. FT.
TOTAL	1,396 SQ. FT.
GARAGE	419 SQ. FT.
COVERED ENTRY	43 SQ. FT.

NOTE: SQUARE FOOTAGE MAY VARY DUE TO METHOD OF CALCULATION

SCALE: 1/4" = 1'- 0"

**PLAN 1390**  
 CLOVIS, CALIFORNIA

WILSON HOMES  
 FRESNO, CALIFORNIA

© 2018 WILLIAM HEZMALALICH ARCHITECTS, INC. dba WHA  
 WHA EXPRESSLY RESERVES ITS COMMON LAW COPYRIGHT AND OTHER PROPERTY RIGHTS IN THESE PLANS. THESE PLANS ARE NOT TO BE REPRODUCED, CHANGED, OR COPIED IN ANY FORM OR MANNER WITHOUT THE WRITTEN PERMISSION AND CONSENT OF WHA. IN THE EVENT OF UNAUTHORIZED REUSE OF THESE PLANS BY A THIRD PARTY, THE THIRD PARTY SHALL HOLD WHA HARMLESS.

NO.	DATE	DESCRIPTION
	10-16-18	AS-BUILT PLAN

AS-BUILT PLAN

PLAN 1390B

PROJECT MANAGER:	MM
DESIGNER:	AM
DRAWN BY:	-
REVIEWED BY:	-
1ST BLDG. DEPT. SUBMITTAL:	-
ISSUED FOR CONSTRUCTION:	-
JOB NUMBER:	2018077
CAD FILE NAME:	A105

DATE: 07-27-18 SHEET: A1.5


2018077 - 07-27-18

FLOOR PLAN KEY NOTES	
Name	NOTE
002	CONCRETE DRIVE (BY OTHERS)
003	CONCRETE WALK (BY OTHERS)
004	CONCRETE PORCH SLAB (BY OTHERS) SLOPE 1/4" PER FOOT MINIMUM IN DIRECTION INDICATED
005	CONCRETE GARAGE SLAB - SLOPE 1/2" PER FOOT MINIMUM IN DIRECTION INDICATED
421	STUCCO CEILING: HEIGHT PER PLAN
422	STUCCO SOFFIT: HEIGHT PER PLAN
551	MANUFACTURED ADHERED STUCCO STONE VENEER - INSTALL PER MANUFACTURERS INSTRUCTIONS* BY EL DORADO STONE PRODUCTS - TER# 1312-81

ARCHITECTS . PLANNERS . DESIGNERS


# WHA.

ORANGE COUNTY . LOS ANGELES . BAY AREA

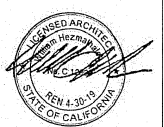


WILSON HOMES

TRACT NUMBER: 6168  
PROJECT TYPE

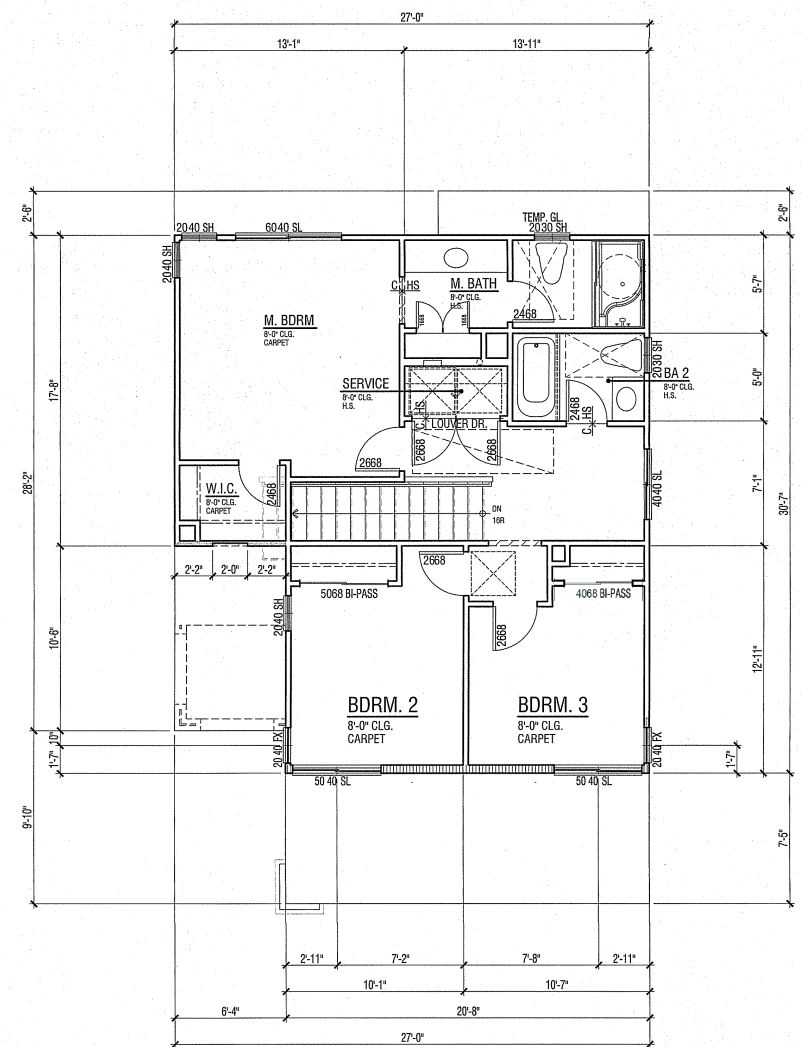

UPPER FLOOR PLAN

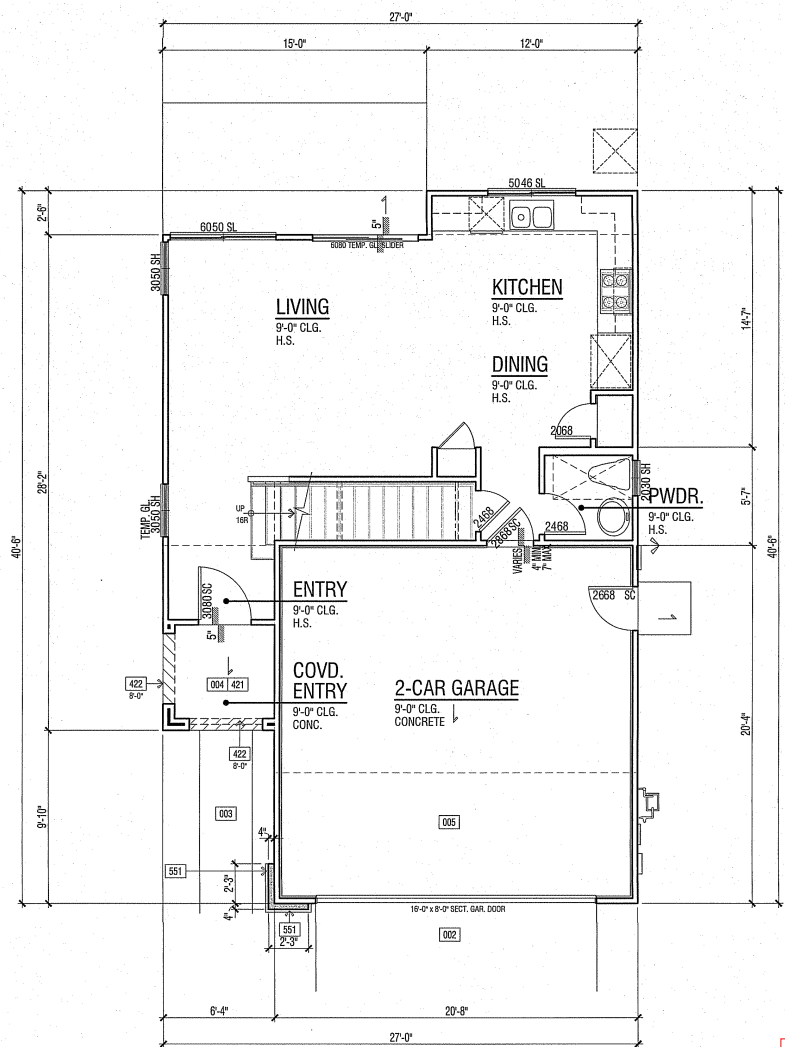


LOWER FLOOR PLAN

**ADDENDA FLOOR PLAN NOTES**

NOTE: SHADED WALLS INDICATE AREAS THAT ARE DIFFERENT THAN THE BASE FLOOR PLAN

NOTE: REFER TO CIVIL AND LANDSCAPE DRAWINGS BY OTHERS FOR ALL DRIVEWAYS AND SIDEWALK LOCATIONS.

REFER TO BASE PLAN SHEET A1.1 FOR ADDITIONAL NOTES AND DIMENSIONS.

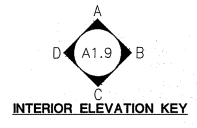

APPL. NO. P19-06281 EXHIBIT F-2 DATE 12/20/2019

PLANNING REVIEW BY \_\_\_\_\_ DATE \_\_\_\_\_

TRAFFIC ENG. \_\_\_\_\_ DATE \_\_\_\_\_

APPROVED BY \_\_\_\_\_ DATE \_\_\_\_\_

CITY OF FRESNO DARM DEPT

**PLAN 1245**  
CLOVIS, CALIFORNIA

WILSON HOMES  
FRESNO, CALIFORNIA

© 2018 WILLIAM HEZMALHALCH ARCHITECTS, INC. dba WHA  
WHA EXPRESSLY RESERVES ITS COMMON LAW COPYRIGHT AND OTHER PROPRIETARY RIGHTS IN THESE PLANS. THESE PLANS ARE NOT TO BE REPRODUCED, CHANGED, OR COPIED IN ANY FORM OR MANNER WHATSOEVER, NOR ARE THEY TO BE ASSIGNED TO A THIRD PARTY WITHOUT FIRST OBTAINING THE WRITTEN PERMISSION AND CONSENT OF WHA. IN THE EVENT OF ANY PROCEEDING OR LITIGATION BY A THIRD PARTY, THE THIRD PARTY SHALL HOLD WHA HARMLESS.

DO NOT SCALE PLANS

**REVISIONS**


NO.	DATE	DESCRIPTION
△ 1	07-02-18	BLDG. DEPT. REVS.
	10-16-18	AS-BUILT PLAN

AS-BUILT PLAN

FLOOR AREA TABLE	PLAN 1245
LOWER FLOOR PLAN	537 SQ. FT.
UPPER FLOOR PLAN	708 SQ. FT.
TOTAL	1,245 SQ. FT.
GARAGE	419 SQ. FT.
COVERED ENTRY	38 SQ. FT.

NOTE: SQUARE FOOTAGE MAY VARY DUE TO METHOD OF CALCULATION

SCALE: 1/4" = 1'-0"

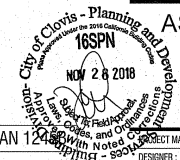

PROJECT MANAGER:	MM
DESIGNER:	AM
DRAWN BY:	-
REVIEWED BY:	-
1ST BLDG. DEPT. SUBMITTAL:	04-25-18
ISSUED FOR CONSTRUCTION:	-
JOB NUMBER:	2018077
CAD FILE NAME:	A105

DATE: 07-02-18 SHEET: A1.5

2018077 - 07-02-18


FLOOR PLAN KEY NOTES	
Name	NOTE
002	CONCRETE DRIVE (BY OTHERS)
003	CONCRETE WALK (BY OTHERS)
004	CONCRETE PORCH SLAB (BY OTHERS) SLOPE 1/4" PER FOOT MINIMUM IN DIRECTION INDICATED
005	CONCRETE GARAGE SLAB - SLOPE 1/4" PER FOOT MINIMUM IN DIRECTION INDICATED
551	MANUFACTURED ADHERED STUCCO STONE VENEER - INSTALL PER MANUFACTURERS INSTRUCTIONS BY EL DORADO STONE PRODUCTS - TER# 1312-01

ARCHITECTS . PLANNERS . DESIGNERS  
**WHA.**  
ORANGE COUNTY . LOS ANGELES . BAY AREA




WILSON HOMES

TRACT NUMBER: 6168/  
PROJECT TYPE: S.F.D.

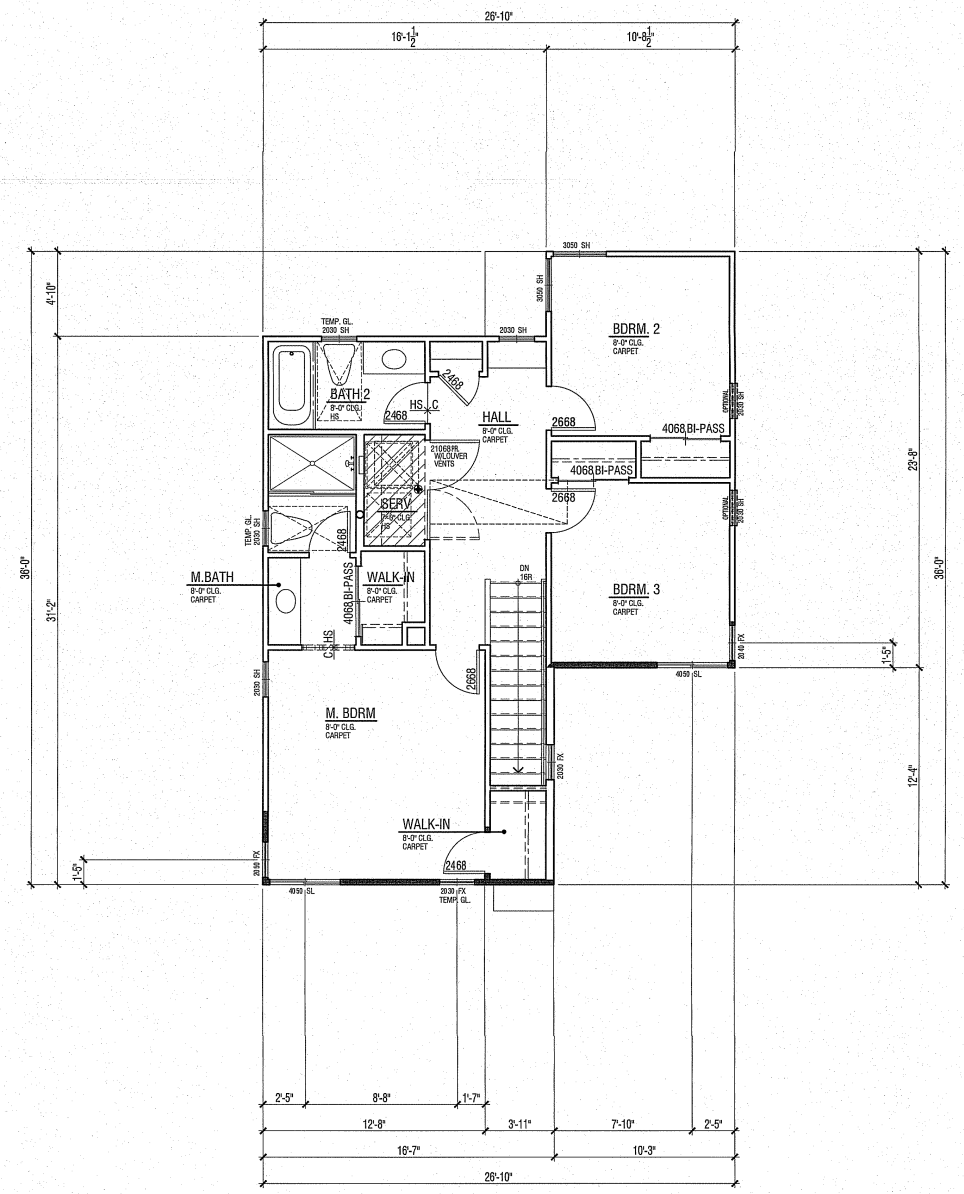


UPPER FLOOR PLAN

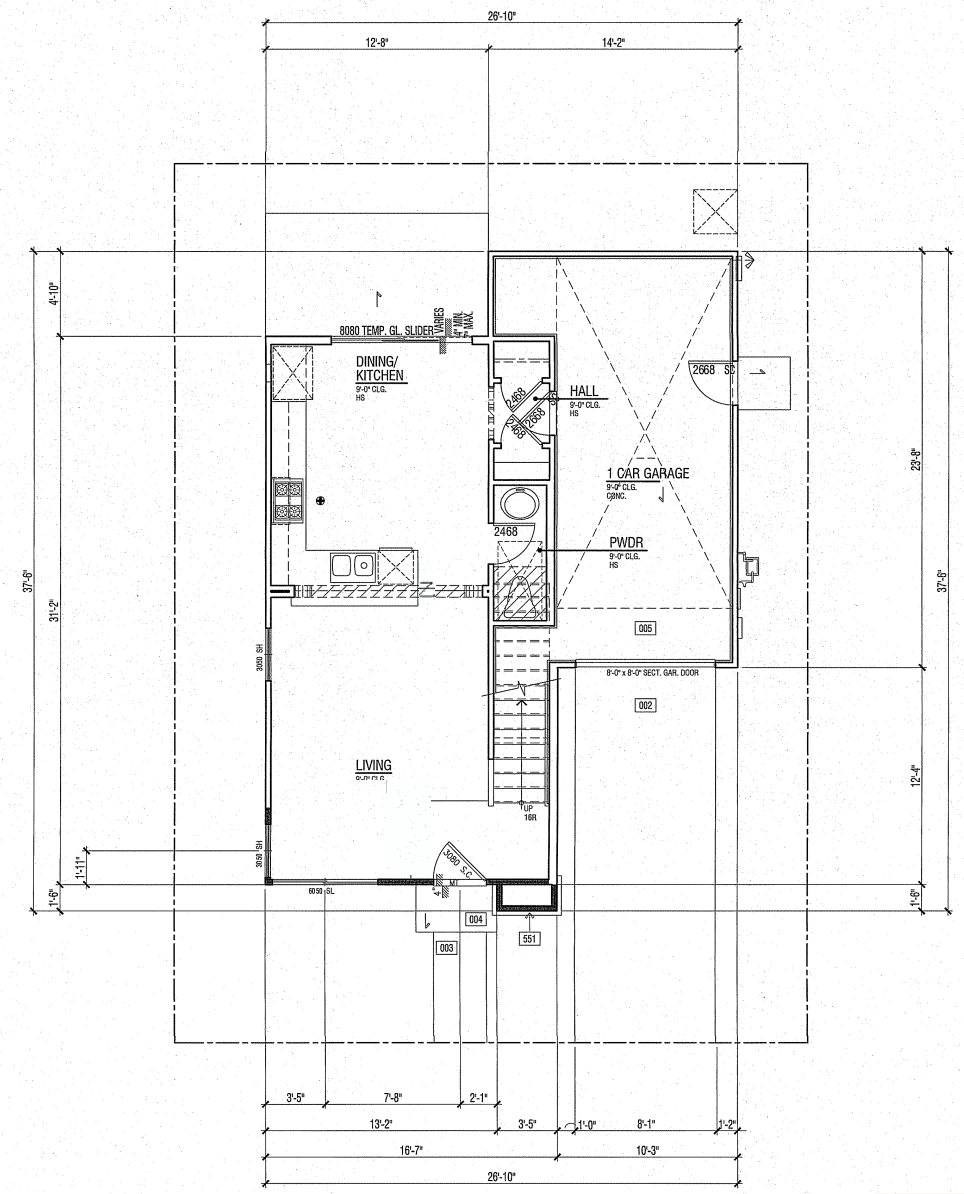

LOWER FLOOR PLAN

**ADDENDA FLOOR PLAN NOTES**  
NOTE: SHADED WALLS INDICATE AREAS THAT ARE DIFFERENT THAN THE BASE FLOOR PLAN  
NOTE: REFER TO CIVIL AND LANDSCAPE DRAWINGS BY OTHERS FOR ALL DRIVEWAYS AND SIDEWALK LOCATIONS.  
REFER TO BASE PLAN SHEET A1.1 FOR ADDITIONAL NOTES AND DIMENSIONS.

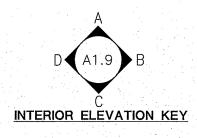

APPL. NO. P19-06281 EXHIBIT F-3 DATE 12/20/19  
PLANNING REVIEW BY \_\_\_\_\_ DATE \_\_\_\_\_  
TRAFFIC ENG. \_\_\_\_\_ DATE \_\_\_\_\_  
APPROVED BY \_\_\_\_\_ DATE \_\_\_\_\_  
CITY OF FRESNO DARM DEPT

FLOOR AREA TABLE		PLAN 1212B
LOWER FLOOR PLAN	490 SQ. FT.	
UPPER FLOOR PLAN	722 SQ. FT.	
TOTAL	1,212 SQ. FT.	
GARAGE	288 SQ. FT.	


NOTE: SQUARE FOOTAGE MAY VARY DUE TO METHOD OF CALCULATION

SCALE: 1/4" = 1'-0"

**PLAN 1212B**  
CLOVIS, CALIFORNIA  
WILSON HOMES  
FRESNO, CALIFORNIA

© 2018 WILLIAM HEZMALHALCH ARCHITECTS, INC. dba WHA  
WHA EXPRESSLY RESERVES ITS COMMON LAW COPYRIGHT AND OTHER PROPERTY RIGHTS IN THESE PLANS. THESE PLANS ARE NOT TO BE REPRODUCED, COPIED, OR TRANSMITTED IN ANY FORM OR BY ANY MEANS, WITHOUT THE WRITTEN PERMISSION AND CONSENT OF WHA. IN THE EVENT OF UNAUTHORIZED REUSE OF THESE PLANS BY A THIRD PARTY, THE THIRD PARTY SHALL HOLD WHA HARMLESS.  
DO NOT SCALE PLANS

REVISIONS		
NO.	DATE	DESCRIPTION

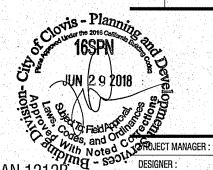

PLAN 1212B	
PROJECT MANAGER:	MM
DESIGNER:	AM
DRAWN BY:	-
REVIEWED BY:	-
1ST BLDG. DEPT. SUBMITTAL:	04-25-18
ISSUED FOR CONSTRUCTION:	-
JOB NUMBER:	2018077
CAD FILE NAME:	A105
DATE:	04-25-18
SHEET:	A1.5

2018077 - FIRST BUILDING DEPARTMENT SUBMITTAL - 04-25-18




FLOOR PLAN KEY NOTES	
NO.	NOTE
002	CONCRETE DRIVE (BY OTHERS)
003	CONCRETE WALK (BY OTHERS)
004	CONCRETE PORCH SLAB (BY OTHERS) SLOPE 1/4" PER FOOT MINIMUM IN DIRECTION INDICATED
005	CONCRETE GARAGE SLAB - SLOPE 1/4" PER FOOT MINIMUM IN DIRECTION INDICATED
421	STUCCO CEILING HEIGHT PER PLAN
425	WOOD SOFFIT HEIGHT PER PLAN

ARCHITECTS . PLANNERS . DESIGNERS  
**WHA.**  
 ORANGE COUNTY . LOS ANGELES . BAY AREA




WILSON HOMES

TRACT NUMBER: 6168  
 PROJECT TYPE

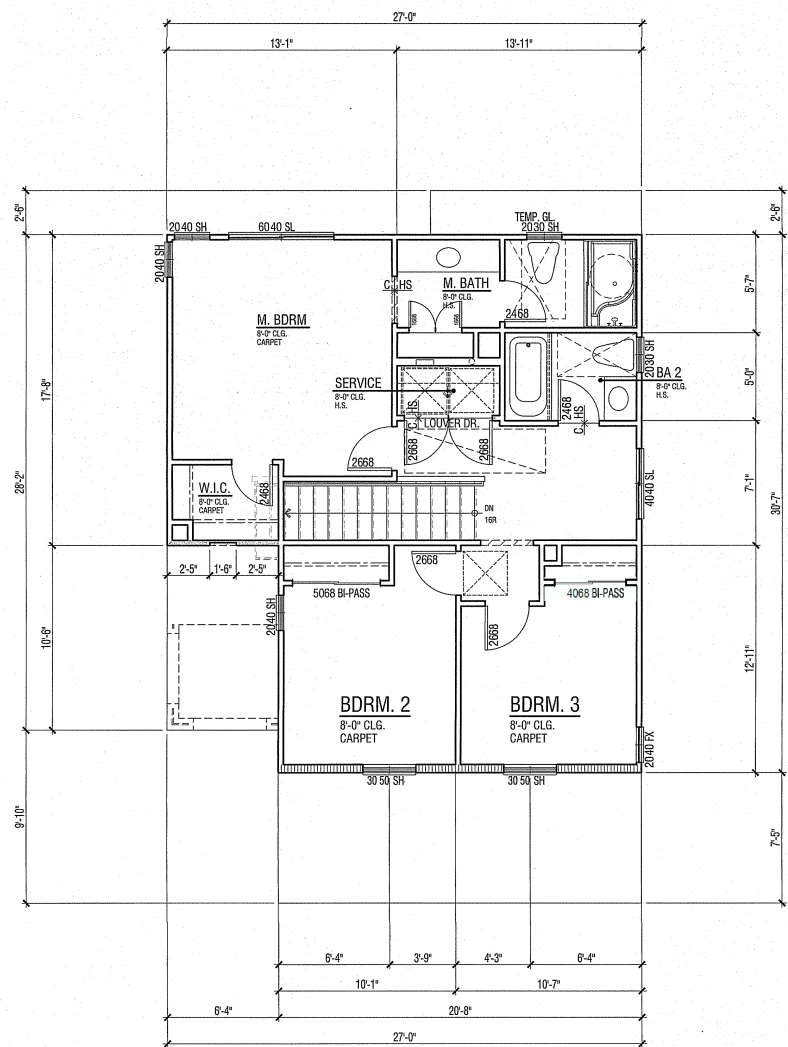


UPPER FLOOR PLAN

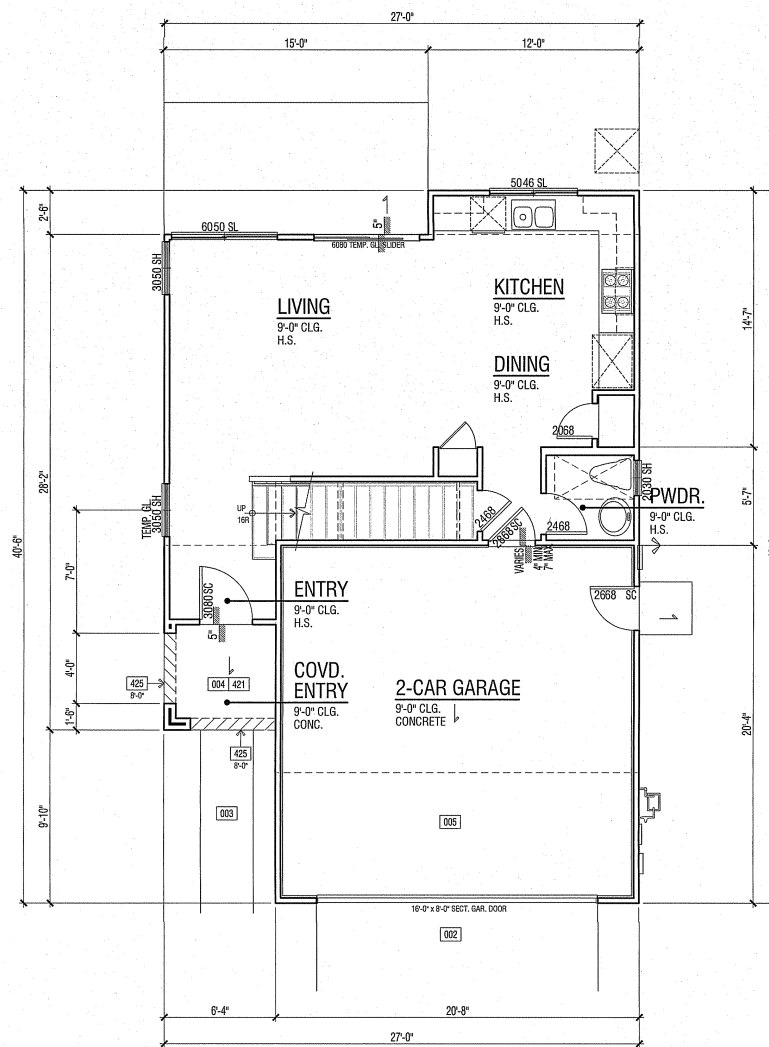

LOWER FLOOR PLAN

**ADDENDA FLOOR PLAN NOTES**  
 NOTE: SHADED WALLS INDICATE AREAS THAT ARE DIFFERENT THAN THE BASE FLOOR PLAN  
 NOTE: REFER TO CIVIL AND LANDSCAPE DRAWINGS BY OTHERS FOR ALL DRIVEWAYS AND SIDEWALK LOCATIONS.  
 REFER TO BASE PLAN SHEET A1.1 FOR ADDITIONAL NOTES AND DIMENSIONS.

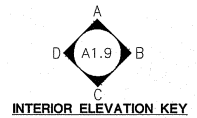

APPL. NO. P19-06281 EXHIBIT F-4 DATE 1/30/2019  
 PLANNING REVIEW BY \_\_\_\_\_ DATE \_\_\_\_\_  
 TRAFFIC ENG. \_\_\_\_\_ DATE \_\_\_\_\_  
 APPROVED BY \_\_\_\_\_ DATE \_\_\_\_\_  
 CITY OF FRESNO DARM DEPT

**PLAN 1245**  
 CLOVIS, CALIFORNIA  
 WILSON HOMES  
 FRESNO, CALIFORNIA

© 2018 WILLIAM HEZMALHALCH ARCHITECTS, INC. dba WHA  
 WHA EXPRESSLY RESERVES ITS COMMON LAW COPYRIGHT AND OTHER PROPERTY RIGHTS IN THESE PLANS. THESE PLANS ARE NOT TO BE REPRODUCED, CHANGED, OR COPIED IN ANY FORM OR MANNER WHATSOEVER, NOR ARE THEY TO BE ASSIGNED TO A THIRD PARTY WITHOUT FIRST OBTAINING THE WRITTEN PERMISSION AND CONSENT OF WHA IN THE EVENT OF ASSIGNMENT. REVIEW OF THESE PLANS BY A THIRD PARTY, THE THIRD PARTY SHALL HOLD WHA HARMLESS.

REVISIONS			
NO.	DATE	DESCRIPTION	BY
1	07-02-18	BLDG. DEPT. REVS.	
	10-16-18	AS-BUILT PLAN	

AS-BUILT PLAN  
 PLAN 1245C

FLOOR AREA TABLE	PLAN 1245C
LOWER FLOOR PLAN	537 SQ. FT.
UPPER FLOOR PLAN	708 SQ. FT.
TOTAL	1,245 SQ. FT.
GARAGE	419 SQ. FT.
COVERED ENTRY	38 SQ. FT.

NOTE: SQUARE FOOTAGE MAY VARY DUE TO METHOD OF CALCULATION

SCALE: 1/4" = 1'- 0"

PROJECT MANAGER:		MM
DESIGNER:	AM	
DRAWN BY:	-	
REVIEWED BY:	-	
1ST BLDG. DEPT. SUBMITTAL:	04-25-18	
ISSUED FOR CONSTRUCTION:	-	
JOB NUMBER:	2018077	
CAD FILE NAME:	A107	

DATE: 07-02-18 SHEET: A1.7


2018077 - 07-02-18

FLOOR PLAN KEY NOTES	
Name	NOTE
002	CONCRETE DRIVE (BY OTHERS)
003	CONCRETE WALK (BY OTHERS)
004	CONCRETE PORCH SLAB (BY OTHERS) SLOPE 1/4" PER FOOT MINIMUM IN DIRECTION INDICATED
005	CONCRETE GARAGE SLAB - SLOPE 1/2" PER FOOT MINIMUM IN DIRECTION INDICATED
421	STUCCO CEILING HEIGHT PER PLAN
428	ARCHED STUCCO SOFFIT HEIGHT PER PLAN




WILSON HOMES

TRACT NUMBER: 6168  
 PROJECT TYPE

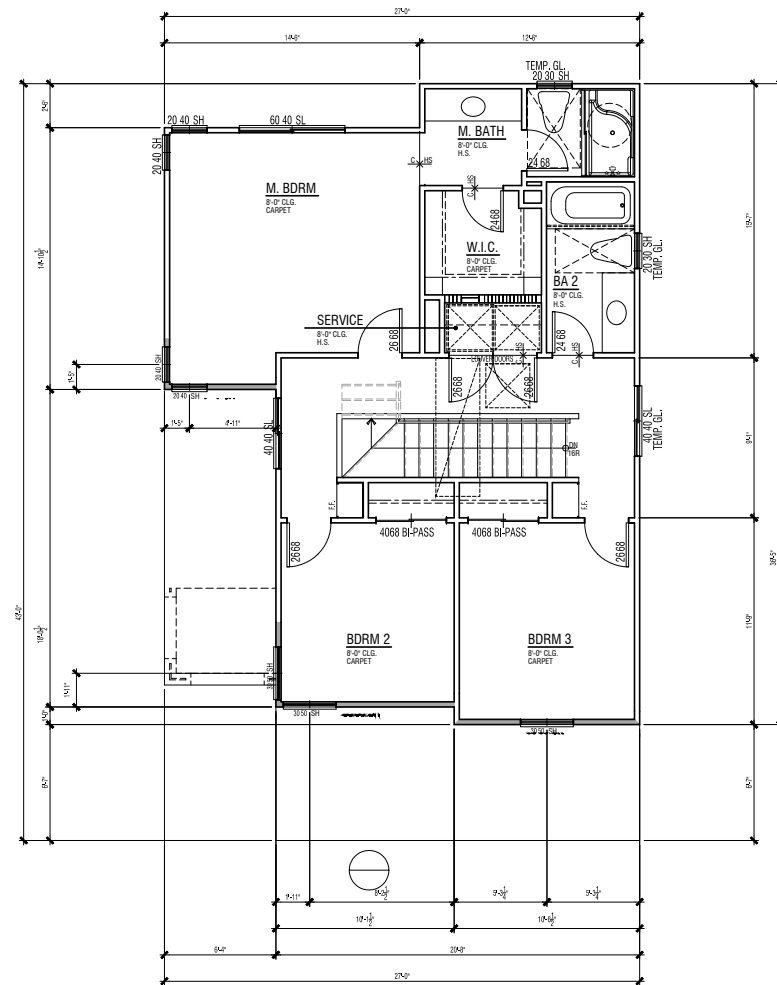

UPPER FLOOR PLAN

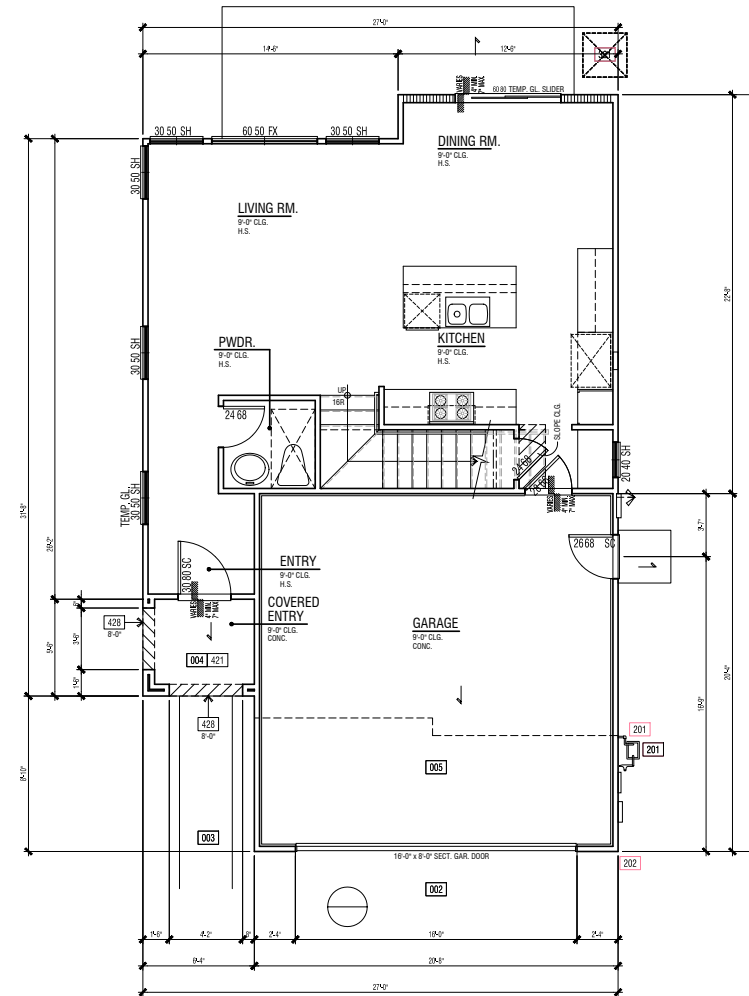

LOWER FLOOR PLAN

**ADDENDA FLOOR PLAN NOTES**  
 NOTE: SHADED WALLS INDICATE AREAS THAT ARE DIFFERENT THAN THE BASE FLOOR PLAN.  
 NOTE: REFER TO CIVIL AND LANDSCAPE DRAWINGS BY OTHERS FOR ALL DRIVEWAYS AND SIDEWALK LOCATIONS.  
 REFER TO BASE PLAN SHEET A1.1 FOR ADDITIONAL NOTES AND DIMENSIONS.



INTERIOR ELEVATION KEY

APPL. NO. P19-06281 EXHIBIT F-5 DATE 12/30/2018  
 PLANNING REVIEW BY \_\_\_\_\_ DATE \_\_\_\_\_  
 TRAFFIC ENG. \_\_\_\_\_ DATE \_\_\_\_\_  
 APPROVED BY \_\_\_\_\_ DATE \_\_\_\_\_  
 CITY OF FRESNO DARM DEPT

FLOOR AREA TABLE	PLAN 1390C
LOWER FLOOR PLAN	616 SQ. FT.
UPPER FLOOR PLAN	774 SQ. FT.
TOTAL	1,390 SQ. FT.
GARAGE	419 SQ. FT.
COVERED ENTRY	43 SQ. FT.

NOTE: SQUARE FOOTAGE MAY VARY DUE TO METHOD OF CALCULATION

SCALE: 1/4" = 1'- 0"

**PLAN 1390**  
 CLOVIS, CALIFORNIA  
 WILSON HOMES  
 FRESNO, CALIFORNIA

© 2018 WILLIAM HEZMALHALCH ARCHITECTS, INC. dba WHA  
 WHA EXPRESSLY RESERVES ITS COMMON LAW COPYRIGHT AND OTHER PROPERTY RIGHTS IN THESE PLANS. THESE PLANS ARE NOT TO BE REPRODUCED, CHANGED, OR COPIED IN ANY FORM OR MANNER WITHOUT THE WRITTEN PERMISSION AND CONSENT OF WHA. IN THE EVENT OF UNAUTHORIZED REUSE OF THESE PLANS BY A THIRD PARTY, THE THIRD PARTY SHALL HOLD WHA HARMLESS.

NO.	DATE	DESCRIPTION
	10-16-18	AS-BUILT PLAN

AS-BUILT PLAN

PLAN 1390C

PROJECT MANAGER:	MM
DESIGNER:	AM
DRAWN BY:	-
REVIEWED BY:	-
1ST BLDG. DEPT. SUBMITTAL:	-
ISSUED FOR CONSTRUCTION:	-
JOB NUMBER:	2018077
CAD FILE NAME:	A107

DATE: 07-27-18 SHEET: A1.7


2018077 - 07-27-18

FLOOR PLAN KEY NOTES	
Name	NOTE
002	CONCRETE DRIVE (BY OTHERS)
003	CONCRETE WALK (BY OTHERS)
004	CONCRETE PORCH SLAB (BY OTHERS) SLOPE 1/4" PER FOOT MINIMUM IN DIRECTION INDICATED
005	CONCRETE GARAGE SLAB - SLOPE 1/2" PER FOOT MINIMUM IN DIRECTION INDICATED

ARCHITECTS . PLANNERS . DESIGNERS


# WHA.

ORANGE COUNTY . LOS ANGELES . BAY AREA

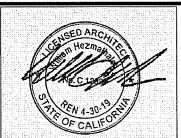


WILSON HOMES

TRACT NUMBER: 6168/  
PROJECT TYPE: S.F.D.

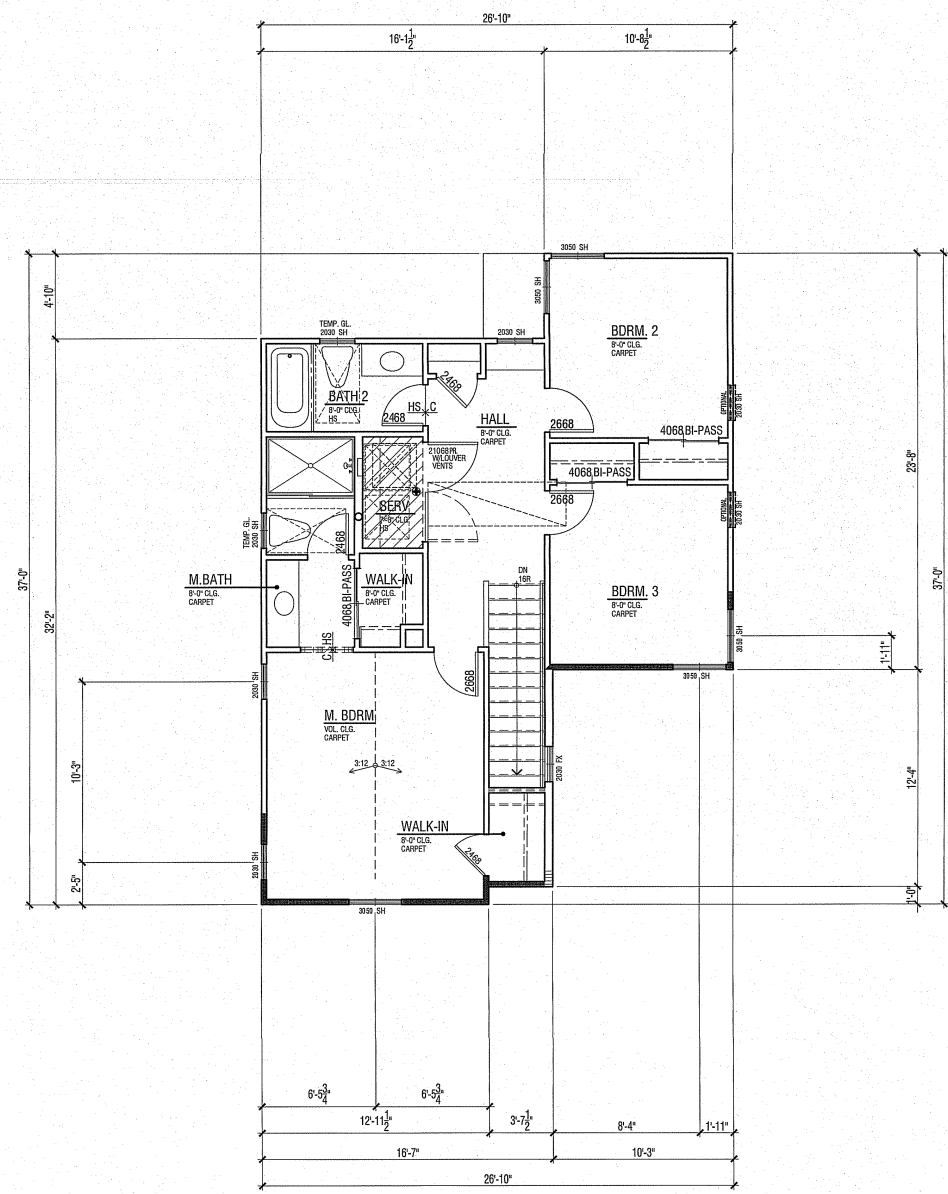

UPPER FLOOR PLAN

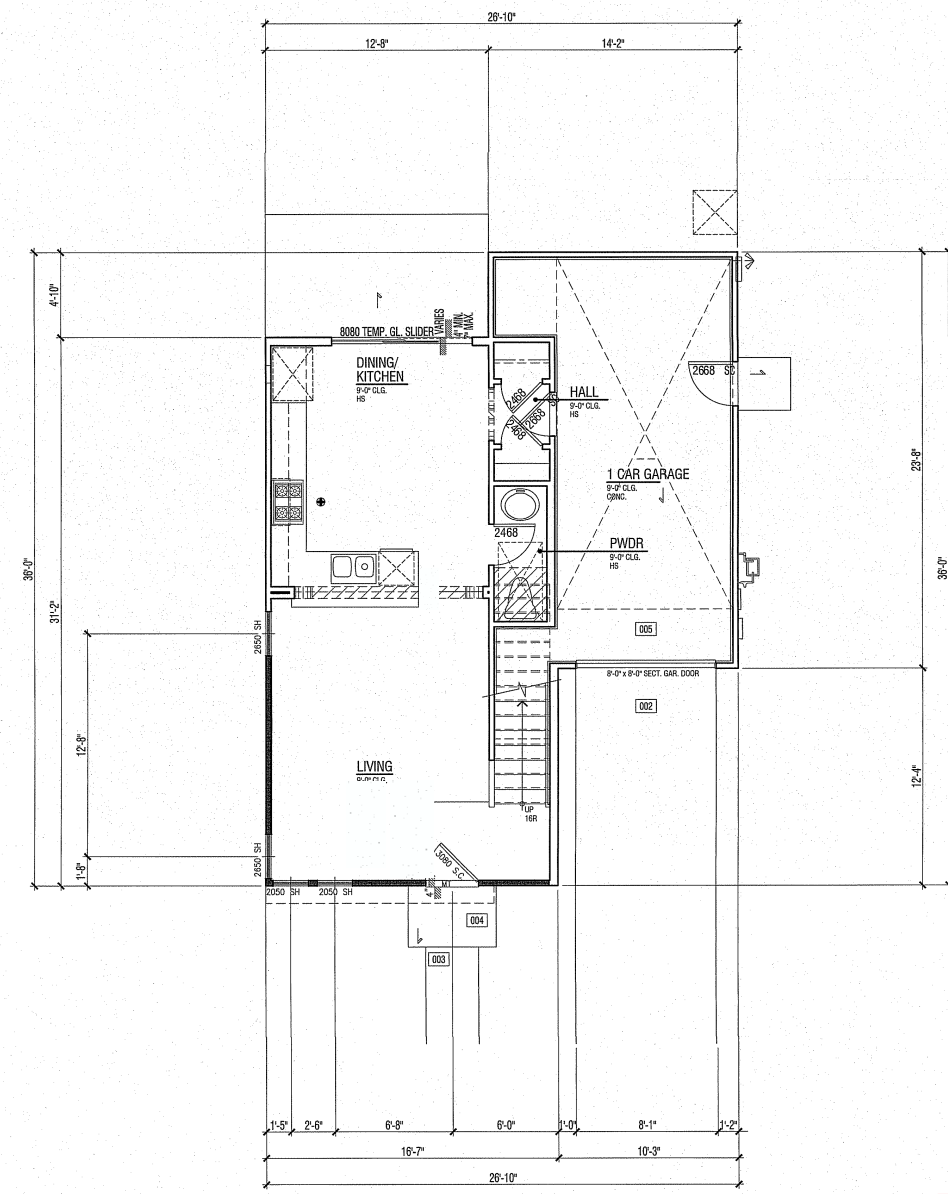


LOWER FLOOR PLAN

**ADDENDA FLOOR PLAN NOTES**

NOTE: SHADED WALLS INDICATE AREAS THAT ARE DIFFERENT THAN THE BASE FLOOR PLAN

NOTE: REFER TO CIVIL AND LANDSCAPE DRAWINGS BY OTHERS FOR ALL DRIVEWAYS AND SIDEWALK LOCATIONS.

REFER TO BASE PLAN SHEET A1.1 FOR ADDITIONAL NOTES AND DIMENSIONS.

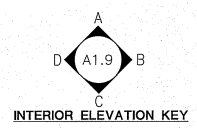

APPL. NO. P19-06281 EXHIBIT F-6 DATE 12/26/2018

PLANNING REVIEW BY \_\_\_\_\_ DATE \_\_\_\_\_

TRAFFIC ENG. \_\_\_\_\_ DATE \_\_\_\_\_

APPROVED BY \_\_\_\_\_ DATE \_\_\_\_\_

CITY OF FRESNO DARM DEPT

FLOOR AREA TABLE	PLAN 1212C
LOWER FLOOR PLAN	490 SQ. FT.
UPPER FLOOR PLAN	735 SQ. FT.
TOTAL	1,225 SQ. FT.
GARAGE	288 SQ. FT.

NOTE: SQUARE FOOTAGE MAY VARY DUE TO METHOD OF CALCULATION

SCALE: 1/4" = 1'- 0"


**PLAN 1212C**  
CLOVIS, CALIFORNIA

WILSON HOMES  
FRESNO, CALIFORNIA

© 2018 WILLIAM HEZMALHALCH ARCHITECTS, INC. (dba WHA) WHA EXPRESSLY RESERVES ITS COMMON LAW COPYRIGHT AND OTHER PROPERTY RIGHTS IN THESE PLANS. THESE PLANS ARE NOT TO BE REPRODUCED, COPIED, OR COPIED IN ANY FORM OR MANNER, WITHOUT FIRST OBTAINING THE WRITTEN PERMISSION AND CONSENT OF WHA. IN THE EVENT OF UNAUTHORIZED REUSE OF THESE PLANS BY A THIRD PARTY, THE THIRD PARTY SHALL HOLD WHA HARMLESS.

DO NOT SCALE PLANS

REVISIONS		
NO.	DATE	DESCRIPTION

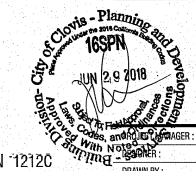

PLAN 1212C

DRAWN BY:	MM
REVIEWED BY:	AM
1ST BLDG. DEPT. SUBMITTAL:	04-25-18
ISSUED FOR CONSTRUCTION:	-
JOB NUMBER:	2018077
CAD FILE NAME:	A107
DATE:	04-25-18
SHEET:	A1.7

2018077 - FIRST BUILDING DEPARTMENT SUBMITTAL - 04-25-18