

Chann

SUPPLEMENTAL FREEWAY AGREEMENT

COPY

1 This Agreement, made and entered into, in duplicate,
 2 this 31st day of March, 1964, by and between
 3 the State of California, acting by and through the Highway
 4 Transportation Agency, Department of Public Works, Division of
 5 Highways, hereinafter for convenience referred to as "the State,"
 6 and the County of Fresno, hereinafter for convenience referred to
 7 as "the County,"

W I T N E S S E T H:

8
 9 WHEREAS, the State and County have heretofore entered
 10 into a Freeway Agreement dated December 22, 1959, relating to
 11 that certain portion of State Highway Route 4 in the County of
 12 Fresno, between 0.4 mile southeast of Highland Avenue and Church
 13 Avenue; and


14 WHEREAS, the plan of construction, as shown on Exhibit
 15 "A" attached to said agreement, has been altered in certain
 16 respects since the date of execution of said agreement; and

17 WHEREAS, a new plan map has been prepared showing the
 18 altered plan of construction;

NOW, THEREFORE, IT IS AGREED:

19
 20 1. That the plan map attached hereto, marked "Revised
 21 Exhibit A", dated February, 1964, shall be substituted for
 22 Exhibit "A" attached to the Freeway Agreement dated December 22,
 23 1959, and become a part of said Agreement for all purposes.

24 2. That except for the substitution of the revised
 25

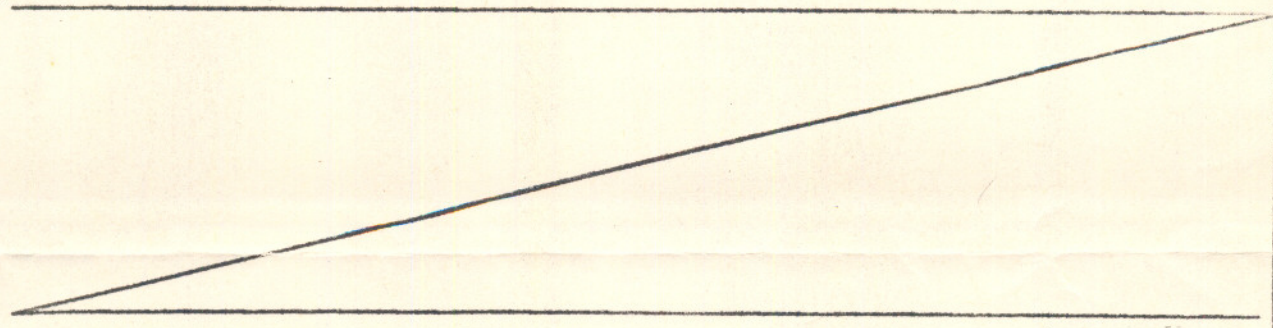

26
 27
 28
 29
 30 plan map, said Freeway Agreement dated December 22, 1959, shall

1 remain in full force and effect, unmodified by any provision of
2 this Agreement.

3 State of California
4 Highway Transportation Agency
5 Department of Public Works

6 JOHN ERRECA
7 Director of Public Works

8 APPROVED:

9 By

10 T. F. Bagshaw

11 T. Fred Bagshaw
12 Assistant Director

13 APR 22 1964

14 [Signature]
15 Deputy State Highway Engineer

16 THE COUNTY OF FRESNO
17 A Body Politic

18 APPROVED AS TO FORM:

19 By

20 [Signature]

21 Chairman
22 Board of Supervisors

23 [Signature]
24 Attorney (State)

25 Approved as to form
26 ROBERT M. WASH.
27 COUNTY COUNSEL

28 By [Signature]
29 Assistant

30 Approved as to
31 Accounting Form

[Signature]
Auditor-Controller

March 31st, 1964

IN THE MATTER OF THAT CERTAIN FREEWAY AGREEMENT)	CHAIRMAN
DATED DECEMBER 22, 1959, RELATING TO STATE)	AUTHORIZED
HIGHWAY ROUTE 4 BETWEEN HIGHLAND AVENUE AND)	TO
CHURCH AVENUE (VI-Fre-4-A,B))	SIGN
-----)	SUPPLEMENTAL
	AGREEMENT

WHEREAS, the Acting Director of Public Works has submitted a proposed Supplemental Freeway Agreement covering that portion State Highway Route 4 in the County of Fresno, between 0.4 mile southeast of Highland Avenue and Church Avenue; which said supplemental Agreement substitutes a revised exhibit "A" without otherwise modifying the terms of the original Agreement executed by the Fresno County Board of Supervisors on December 22, 1959; and,

WHEREAS, the two freeway projects covered by the original Agreement were completed on November 13th and October 29th, 1963; and, the revised exhibit "A", Drawing No. 5-101 R-1 dated February 1964, reflects the as-built conditions and includes the changes made during the design and construction of said freeway projects,

Now, therefore, adopting the recommendation of the Acting Director of Public Works, and upon motion of Supervisor Olsen, seconded by Supervisor Malm, and carried, authorization is hereby granted for the Chairman of the Board to execute the aforementioned Supplemental Freeway Agreement for, and on behalf of the County of Fresno.

ADOPTED by the Fresno County Board of Supervisors this 31st day of March, 1964, by the following vote, to wit:

AYES: Supervisors Olsen, Malm, Foley, Andreas, McCormick

NOES: None


ABSENT: None

cc: Public Works (2) ✓
Auditor Controller
File

STATE OF CALIFORNIA,)
COUNTY OF FRESNO.)
J. L. BROWN, County Clerk and ex-officio Clerk of the Board of Supervisors of said County, do hereby certify the foregoing to be a full, true and correct copy of the original Resolution
now of record in my office.
IN WITNESS WHEREOF, I have hereunto set my hand and official seal of said Board of Supervisors this 31st day of April, 1964.
J. L. BROWN
County Clerk and Ex-officio Clerk of said Board of Supervisors.
By: Angel Brooks, Deputy Clerk.

Choon

REVISED EXHIBIT A

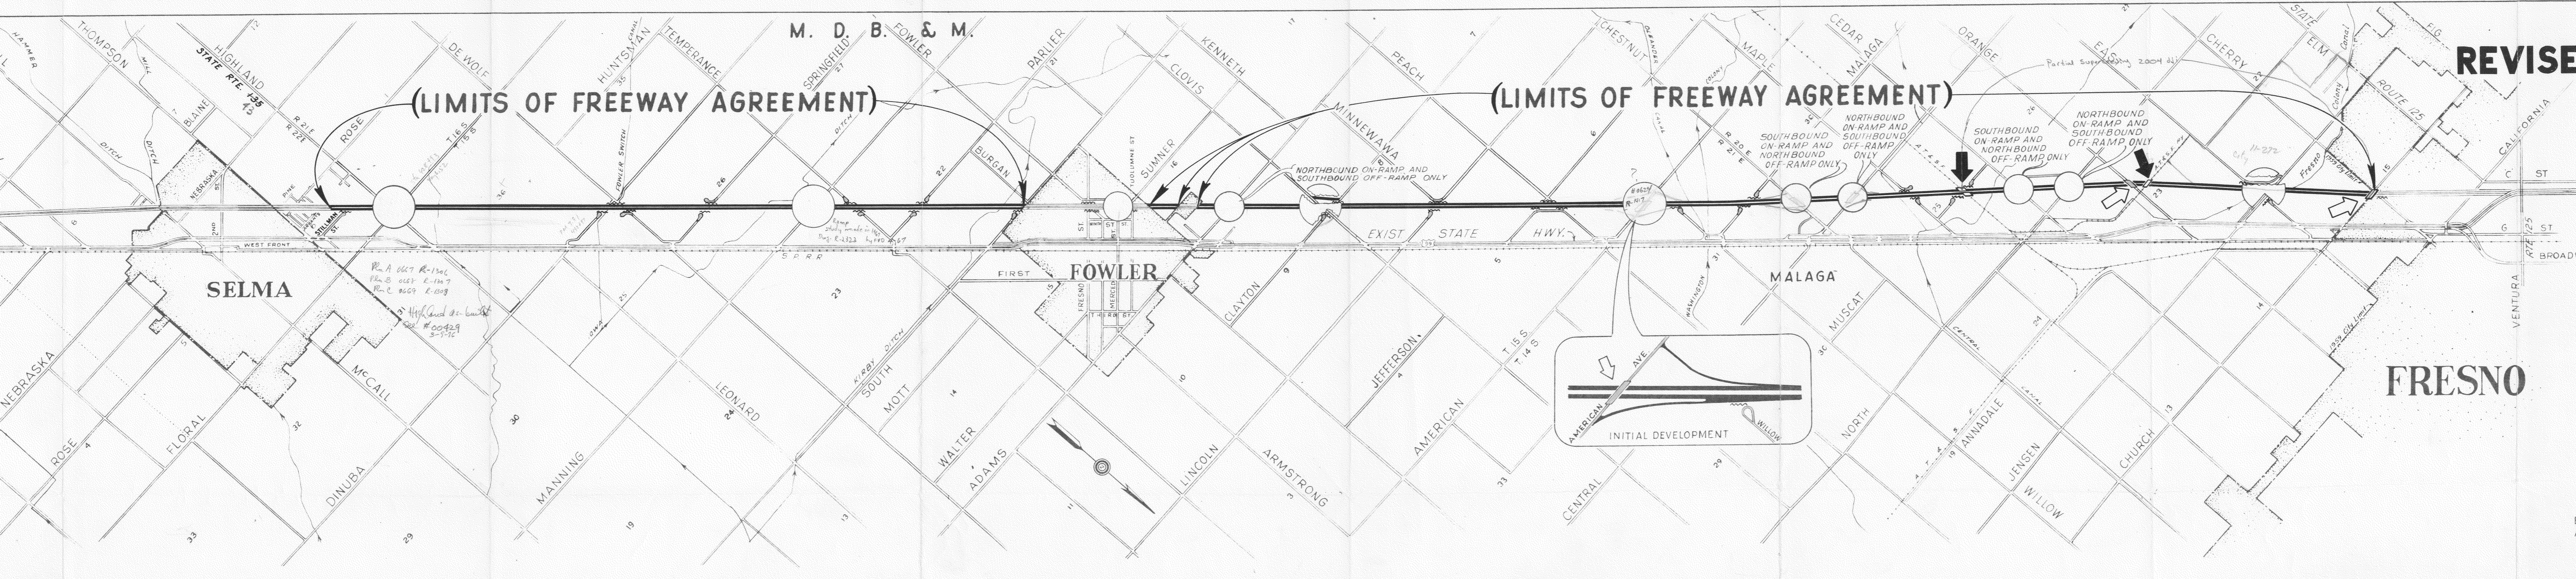

Legend

- INTERCHANGES ○
- FREEWAY LANES AND CONNECTIONS —
- COUNTY ROADS —
- GRADE SEPARATIONS, COUNTY ROADS ↗
- GRADE SEPARATIONS, RAILROADS ↘
- ROAD CLOSURES ~

STATE OF CALIFORNIA
DEPARTMENT OF PUBLIC WORKS
DIVISION OF HIGHWAYS

SKETCH MAP PORTION OF **FREEWAY** VI-FRE-4-A,B

BETWEEN 0.4 MILE SOUTHEAST OF HIGHLAND
AVE. AND CHURCH AVE.